

UNION  
C 2012

MISSISSIPPI DEPARTMENT OF NATURAL RESOURCES  
Bureau of Land and Water Resources  
Southport Mall  
P.O. Box 10631  
Jackson, Mississippi 39209  
WATER WELL DRILLERS LOG

MARCH 1986 Leeper Drilling Union  
date well completed firm name county well located

LANDOWNER: Rank Boyte  
Hiway 15 N  
New Albany Ms.  
(mailing address)  
WELL LOCATION:  
sec. 20 T-6 N R-3 E  
4 miles N of New Albany  
(distance) (direction) (nearest town)

description of formations encountered	depth	
	from	to
TOP CLAY	0	20
Red Sand	20	60
Blue clay	60	100
Rocks + Brown Sand	100	170
White Sand	170	207

WELL PURPOSE: Home  
(home, irrigation, municipal, industrial)

WELL COMPLETION DATA:  
(1) diameter (inches) 4"  
(2) total depth (feet) 207 ft  
(3) static water level (feet) 160 below top of ground.  
(4) casing PVC, 197 (material) (depth)  
4" (size) if telescope see back.  
(5) screen 10' 197 (length) (depth to top)  
4" PVC (size) (material)  
(6) pump 3/4 8 (HP) (yield gpm)  
5 sec (type power)  
(7) electric log NO (yes or no)  
(organization running log)


(8) how well bottom plugged  
Backwash valve

DRILLERS REMARKS:

DISCLOSED  
APR 11 1986  
Department of Natural Resources  
Bureau of Land & Water Resources

If well telescopes please sketch and show depths.

GROUND LEVEL

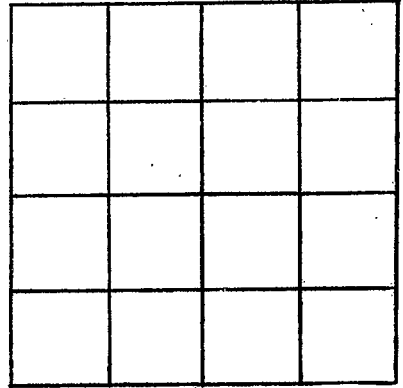

SECTION \_\_\_\_\_

Please indicate well location X.

ADDITIONAL INFORMATION

If more than one screen,  
show locations of each on sketch.