

**MISSISSIPPI DEPARTMENT OF ENVIRONMENTAL QUALITY**

Office of Land and Water Resources

P. O. Box 10631  
Jackson, MS 39289-0631  
**WATER WELL DRILLERS LOG**

COUNTY WELL LOCATED <b>UNION</b>	
WELL NUMBER <b>C</b>	CODED
DATE WELL COMPLETED <b>2020 DEC 1994</b>	

PERMIT NUMBER
NAME OF DRILLING FIRM <b>CLIPPER Drilling</b>
<b>Pod to to c</b>

NAME & MAILING ADDRESS OF LANDOWNER <b>Steve Latham</b>		
New Albany, MS		
WELL LOCATION: SEC	TOWNSHIP	RANGE
<b>23</b>	<b>6</b> <sup>N</sup> <sub>S</sub>	<b>3</b> <sup>E</sup> <sub>W</sub>
DISTANCE <b>7</b> Miles	DIRECTION <b>NE</b>	NEAREST TOWN <b>New Albany</b>
OTHER LANDMARK <b>Wells Chapel Church Area</b>		
WELL PURPOSE: Home, Irrigation, Municipal, Industrial, Fish Pond, etc. <b>Home</b>		

<b>PUMP DATA</b>			
PUMP TYPE (Circle One): <input checked="" type="radio"/> Submersible, <input type="radio"/> Turbine, <input type="radio"/> Jet <input type="radio"/> Flowing Well, Other (Describe) _____			
POWER TYPE (Circle One): <input checked="" type="radio"/> Electric, <input type="radio"/> Tractor, <input type="radio"/> Diesel, <input type="radio"/> Gasoline <input type="radio"/> Butane, Other (Describe) _____ H/P <b>12</b>			
Pump Capacity (GPM) <b>10</b>	No. of Stages <b>9</b>	Setting Depth <b>70</b>	FT.
PUMP TEST Well yielded _____ GPM with a drawdown of _____ ft. after _____ hours of pumping			

<b>WELL DATA</b>		
Well Depth <b>87'</b>	Casing Diameter (In.) <b>4"</b>	Casing Length (Ft.) <b>71'</b>
Type of Casing <b>PVC</b>	Hole Depth <b>87'</b>	Depth to Static Water Level <b>30'</b>

<b>LOG DATA</b>			
TYPE OF LOG RUN (Circle One): <input type="radio"/> No Log Run, <input type="radio"/> Electric, <input type="radio"/> Gamma Ray, <input type="radio"/> Density, <input type="radio"/> Sonic, <input type="radio"/> Neutron, Other (Describe) _____			
Name of Organization Running Log			

TYPE OF COMPLETION: (Circle One or More): <input checked="" type="radio"/> Gravel Packed, <input type="radio"/> Underreamed, <input type="radio"/> Telescoped, <input type="radio"/> Natural Development, <input type="radio"/> Open Hole, <input type="radio"/> Other (Describe) _____		
WELL GROUTED TO A DEPTH OF <b>10</b> FEET Type Grout (circle one): Cement, Bentonite, <input checked="" type="radio"/> or Mix		

<b>GEOLOGIC DATA (Office Use Only)</b>			
Surface Elev.	Geologic Unit	Unit Thickness	Depth to Top
Subs. SWL	Date	Analysis	Aquifer Test

<b>SCREEN DATA</b>		
Diameter - Inches <b>4"</b>	Length - Feet <b>10'</b>	Slot Size - Inches <b>.010</b>
Screen Type <b>Slotted PVC</b>	Depth to Bottom - Feet <b>87'</b>	


Driller's Remarks	
Top of Lap Pipe or Reduction in Casing	
<b>FEET</b>	IF TELESCOPED OR MORE THAN ONE SCREEN: USE BACK PAGE

DESCRIPTION OF FORMATIONS ENCOUNTERED	FROM	TO
<b>TOP CLAY</b>	<b>0</b>	<b>20</b>
<b>Red Sand</b>	<b>20</b>	<b>35</b>
<b>Blue clay</b>	<b>35</b>	<b>70</b>
<b>SAND</b>	<b>70</b>	<b>87</b>

FORMATIONS (Continued)	FROM	TO
<b>DEC 11 1995</b>		
Dept. of Environmental Quality Office of Land and Water Resources		
IF MORE SPACE IS NEEDED, USE BACK		

If well telescopes please sketch and show depths.

GROUND LEVEL

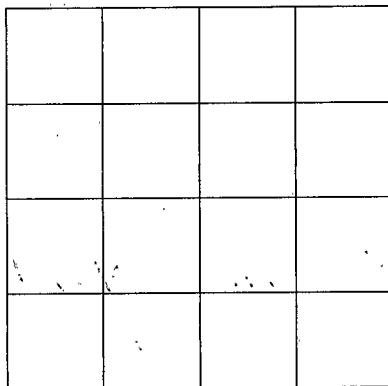

SECTION \_\_\_\_\_

Please indicate well location X.

ADDITIONAL INFORMATION

If more than one screen,  
show location of each on sketch.