

UNION
D9
4-9-71

MISSISSIPPI
BOARD OF WATER COMMISSIONERS
416 North State Street
Jackson, Mississippi 39201

CODED

WATER WELL DRILLERS LOG

4-9-1971 JT Madlin Union
date well completed firm name county well located

LANDOWNER: Paul Wilder
New Albany
Keownville Comm
(mailing address)

description of formations encountered	from	to
	Red clay	0
Yellow sand	9	18
Blue sand	18	40
Blue sand	40	65
Blue sand	65	98
Blue sand	98	130
Blue sand	130	180

WELL LOCATION:
sec. 20 T. 6 N. R. 4 E
S W
1/2 miles E of Keownville
(distance) (direction) (nearest town)

WELL PURPOSE:
(home, irrigation, municipal, industrial)

WELL COMPLETION DATA:

(1) diameter (inches) 4

(2) total depth (feet) 180

(3) static water level (feet) 30 below top of ground.

(4) casing P 120 (material) (depth)
(size) If telescope see back.

(5) screen 20 100 (length) (depth to top)
4 P (size) (material)

(6) pump 1/2 6 (HP) (yield gpm)
E (type power)

(7) electric log (yes or no)

(organization running log)

(8) how well bottom plugged BW

CODED


MAY 4 - 1971

MISC. DE. OF
WATER COMMISSIONERS

DRILLERS REMARKS:

If well telescopes please
sketch and show depths.

GROUND LEVEL

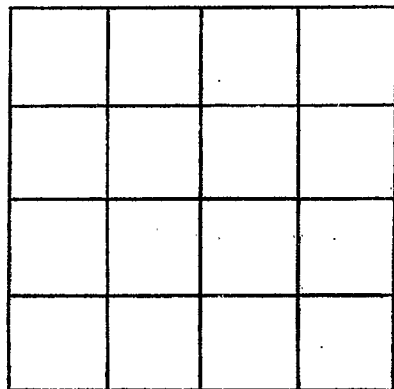

SECTION _____

Please indicate well location X.

ADDITIONAL INFORMATION

If more than one screen,
show locations of each on sketch.