

Union Co.
D10
4-69

MISSISSIPPI
BOARD OF WATER COMMISSIONERS
416 North State Street
Jackson, Mississippi 39201

CODED

WATER WELL DRILLERS LOG **CODED**

4 28 19 69 J T Madlin
date well completed firm name county well located

LANDOWNER: Eugene Carnell
New Albany
Miss.
(mailing address)

description of formations encountered	from	to
clay	0	30
Rock & clay	350	80
Flint clay	80	150
Rock & sand	230	240

WELL LOCATION:
sec. 4 T. 6 N. R. 4 E.
6 miles E of New Albany
(distance) (direction) (nearest town)

WELL PURPOSE:
(home, irrigation, municipal, industrial)

WELL COMPLETION DATA:

- (1) diameter (inches) 4"
- (2) total depth (feet) 240
- (3) static water level (feet) 110 below top of ground.
- (4) casing (material) (depth) 100
If telescope see back.
- (5) screen (length) (depth to top)
(size) (material)
- (6) pump (HP) (yield gpm) 5
(type power)
- (7) electric log (yes or no)
(organization running log)
- (8) how well bottom plugged

CODED


JUN 14 1969

MISS. Bd. of Water Comm.

DRILLERS REMARKS

If well telescopes please sketch and show depths.

GROUND LEVEL

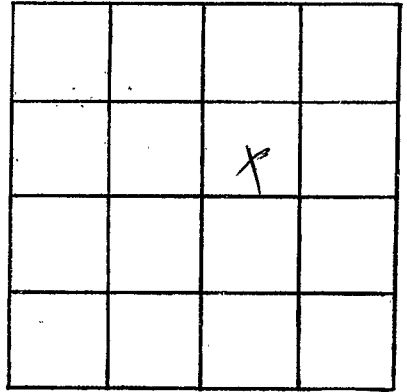

SECTION _____

Please indicate well location X.

ADDITIONAL INFORMATION

If more than one screen, show locations of each on sketch.