

**MISSISSIPPI
BOARD OF WATER COMMISSIONERS**
416 North State Street
Jackson, Mississippi 39201

CODED

WATER WELL DRILLERS LOG

Union
D 11
5-69

5 12 19 69 J T Walker Union
 date well completed firm name county well located

LANDOWNER: J. T. Walker
 Mrs. J. T. Walker
 (mailing address)

description of formations encountered	from	to
	Red clay	0
Blue clay	30	160
Rock sand	160	26

WELL LOCATION:
 sec. 19 T 6 N R 4 E
 2 miles NW of Kumbia
 (distance) (direction) (nearest town)

WELL PURPOSE:
 (home, irrigation, municipal, industrial)


- WELL COMPLETION DATA:**
- (1) diameter (inches) 5 1/2
 - (2) total depth (feet) 200
 - (3) static water level (feet) 160 below top of ground
 - (4) casing (material) PL (depth) 200
 (size) If telescope see back.
 - (5) screen (length) 10 (depth to top) 160
 (size) 5" (material) PL
 - (6) pump (type) 1/2 (yield gpm) 4
 (type power) E
 - (7) electric log (yes or no)
 - (organization running log)
 - (8) how well bottom plugged

DRILLERS REMARKS:

NOV 1 1969
 MISSISSIPPI BOARD OF WATER COMMISSIONERS

If well telescopes please sketch and show depths.

GROUND LEVEL

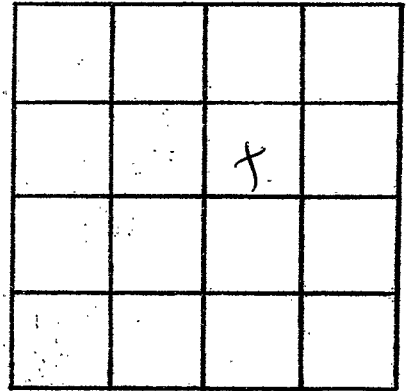

SECTION _____

Please indicate well location X.

ADDITIONAL INFORMATION

If more than one screen, show locations of each on sketch.