

CODED

MISSISSIPPI
BOARD OF WATER COMMISSIONERS
416 North State Street
Jackson, Mississippi 39201

WATER WELL DRILLERS LOG

Union
D12
7-10-69

July 10 1969 JST Media Union
date well completed firm name county well located

LANDOWNER: S.D. Howard
Pleasant Ridge
Miss
(mailing address)

description of formations encountered	from	to
Red Clay	0	30
Red Sand	30	53
White Sand	53	100
Rock & Clay	60	100
Rock	100	104
Sand	104	125

WELL LOCATION:
sec. 4 T 6 N R 4 E
S W
2 miles N of Pleasant Ridge
(distance) (direction) (nearest town)

WELL PURPOSE:
(home, irrigation, municipal, industrial)

WELL COMPLETION DATA: July 13, 1969


- (1) diameter (inches) 4
- (2) total depth (feet) 125
- (3) static water level (feet) 100 below top of ground.
- (4) casing P 125 (material) (depth)
4 (size) if telescope see back.
- (5) screen 20 105 (length) (depth to top)
4 P (size) (material)
- (6) pump 1 6 (HP) (yield gpm)
E (type power)
- (7) electric log (yes or no)
(organization running log)
- (8) how well bottom plugged

ANN 31
MISS. BD. OF
WATER COMM.

DRILLERS REMARKS:

If well telescopes please sketch and show depths.

GROUND LEVEL

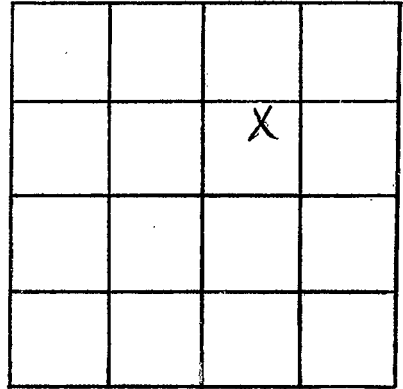

SECTION _____

Please indicate well location X.

ADDITIONAL INFORMATION

If more than one screen,
show locations of each on sketch.