

CODED

MISSISSIPPI
BOARD OF WATER COMMISSIONERS
416 North State Street
Jackson, Mississippi 39201

WATER WELL DRILLERS LOG

CODED

U. N. W. N.
D 13
8-26-60

Aug 26 1960 J. T. Medlin UNION
date well completed firm name county well located

LANDOWNER: Mr. E. J. E.
Kearnsville Miss
New Albany R#
(mailing address)

description of formations encountered	from	to
Red Clay	0	17 1/2
1' sand	17 1/2	38
Blue Clay	38	60
White sand	60	70
Blue sand	70	245
White sand	245	600
1' sand	600	600

WELL LOCATION:
sec. 34 T. 6 N. R. 4 E
3 miles SE of Kearnsville
(distance) (direction) (nearest town)

WELL PURPOSE: house
(home, irrigation, municipal, industrial)

WELL COMPLETION DATA:

- (1) diameter (inches) 4"
- (2) total depth (feet) 600
- (3) static water level (feet) 120 (below top of ground)
- (4) casing Plastic 140 (material) (depth)
(size) if telescope see back.
- (5) screen (length) (depth to top)
(size) (material)
- (6) pump 1 1/2 (HP) 6 (yield gpm)
(type power)
- (7) electric log (yes or no) X
(organization running log)
- (8) how well bottom plugged

CODED


JUN 27 1960

MISS. BD. OF
WATER COMMISSIONERS

DRILLERS REMARKS:

If well telescopes please sketch and show depths.

GROUND LEVEL

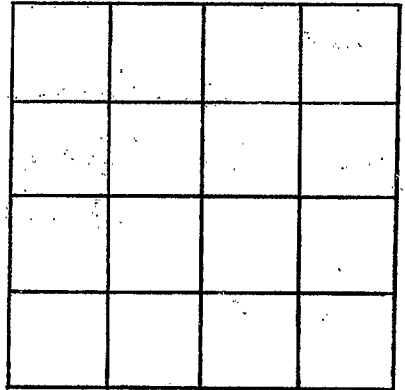

SECTION _____

Please indicate well location X.

ADDITIONAL INFORMATION

If more than one screen, show locations of each on sketch.