

UNION  
D16  
11-19-70

MISSISSIPPI  
BOARD OF WATER COMMISSIONERS  
416 North State Street  
Jackson, Mississippi 39201

**CODED**

WATER WELL DRILLERS LOG

11 19 1970 date well completed  
J T Medlin firm name  
UNION county well located

LANDOWNER: Methodist  
Baslor home  
Kennel Albany Rt 3  
(mailing address)

WELL LOCATION:  
sec. 21 T. 6 N. R. 4 E  
S W  
1 miles E Kennelville  
(distance) (direction) (nearest town)

WELL PURPOSE:  
(home, irrigation, municipal, industrial)

- WELL COMPLETION DATA:
- (1) diameter (inches) 4
  - (2) total depth (feet) 98
  - (3) static water level (feet) 20 below top of ground.
  - (4) casing P 98  
(material) (depth)  
(size) If telescope see back.
  - (5) screen 20 28  
(length) (depth to top)  
4 P  
(size) (material)
  - (6) pump 1/2 11  
(HP) (yield gpm)  
E  
(type power)
  - (7) electric log \_\_\_\_\_  
(yes or no)  
(organization running log)
  - (8) how well bottom plugged Blue clay

description of formations encountered	from	to
Clay	0	19
sand	19	28
Blue clay	28	42
Sand	42	48
Blue	48	60
Sand	60	78
Blue	78	82
Sand	82	92
Blue	92	98

**CODED**


DEC 3 1970

DRILLERS REMARKS:

MISS. Bd. of  
WATER Comm.

If well telescopes please sketch and show depths.

GROUND LEVEL

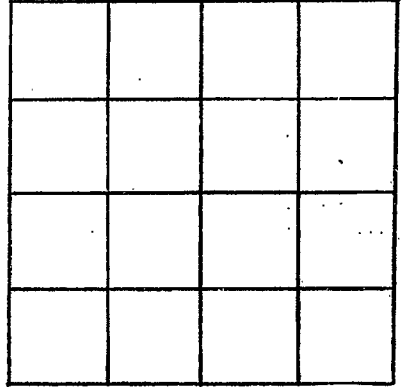

SECTION \_\_\_\_\_

Please indicate well location X.

ADDITIONAL INFORMATION

If more than one screen, show locations of each on sketch.