

UNION
D18
9-14-72

MISSISSIPPI
BOARD OF WATER COMMISSIONERS
416 North State Street
Jackson, Mississippi 39201

200.00
25.00
235.00

WATER WELL DRILLERS LOG

CODED


9 14 19 72 *J T Medlin* *Union*
date well completed firm name county well located

LANDOWNER:	description of formations encountered	from	to
<i>Borde & Threlkeld</i>	Clay	0	14
<i>New Albany Rt#</i> (mailing address)	Rock 10	14	110
WELL LOCATION:	<i>Clay</i>	0	14
sec. <i>6</i> T. <i>E</i> N. R. <i>4</i>	<i>Rock 10</i>	14	110
<i>3</i> miles of <i>Keosauqua</i>	<i>1" S Sand</i>	110	160
(distance) (direction) of (nearest town)			
WELL PURPOSE: (home, irrigation, municipal, industrial)			
WELL COMPLETION DATA:			
(1) diameter (inches) <i>4</i>			
(2) total depth (feet) <i>160</i>			
(3) static water level (feet) <i>105</i> below top of ground.			
(4) casing <i>P</i> <i>100</i> (material) (depth)			
(size) if telescope see back.			
(5) screen <i>1</i> <i>1</i> (length) (depth to top)			
(size) (material)			
(6) pump <i>15</i> <i>5</i> (HP) (yield gpm)			
<i>E</i> (type power)			
(7) electric log _____ (yes or no)			
(organization running log)			
(8) how well bottom plugged <i>0</i>			
DRILLERS REMARKS:			

CODED

If well telescopes please sketch and show depths.

GROUND LEVEL

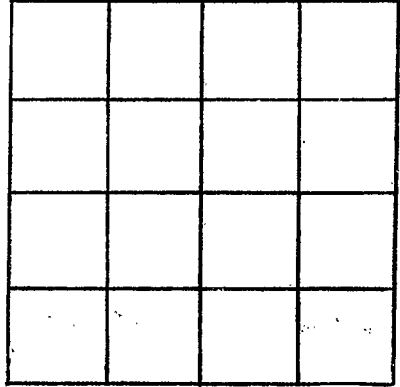

SECTION _____

Please indicate well location X.

ADDITIONAL INFORMATION

Lined area for additional information, consisting of approximately 20 horizontal lines.

If more than one screen, show locations of each on sketch.