

UNION
D20
6-27-73

MISSISSIPPI
BOARD OF WATER COMMISSIONERS
416 North State Street
Jackson, Mississippi 39201

200 00
400 00
600 00
CODED

WATER WELL DRILLERS LOG

6-27-1973 *JT Mullins* *W.M.M.*
date well completed firm name county well located

LANDOWNER:
William Dawson

(mailing address)

description of formations encountered	from	to
<i>red clay</i>	<i>0</i>	<i>16</i>
<i>blue "</i>	<i>13</i>	<i>60</i>
<i>blue clay sand</i>	<i>60</i>	<i>170</i>

WELL LOCATION:
sec. *13* T *6* N R *3* E
4 miles *N* of *Keosaupe*
(distance) (direction) (nearest town)

WELL PURPOSE:
(home, irrigation, municipal, industrial)

- WELL COMPLETION DATA:
- (1) diameter (inches) _____
 - (2) total depth (feet) *170*
 - (3) static water level (feet) *90* below above top of ground.
 - (4) casing *P* *170*
(material) (depth)
 - _____ if telescope see back.
(size)
 - (5) screen *10* *130*
(length) (depth to top)
 - 4* _____
(size) (material)
 - (6) pump *1/2* _____
(HP) (yield gpm)
 - _____ (type power)
 - (7) electric log _____
(yes or no)
 - _____ (organization running log)
 - (8) how well bottom plugged *cap*


CODED

JUL 23 1973

DRILLERS REMARKS:

If well telescopes please
sketch and show depths.

GROUND LEVEL

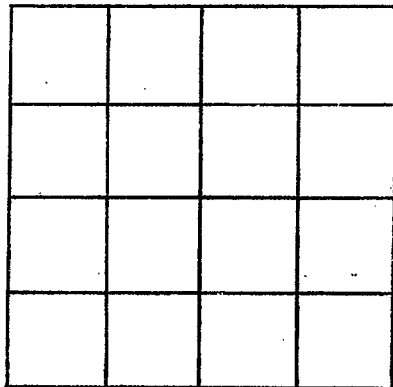

SECTION _____

Please indicate well location X.

ADDITIONAL INFORMATION

If more than one screen,
show locations of each on sketch.