

D 21
 UNION
 7-16-73

MISSISSIPPI
 BOARD OF WATER COMMISSIONERS
 416 North State Street
 Jackson, Mississippi 39201

710 00
 3550
 7350

CODED

WATER WELL DRILLERS LOG

7 16 19 73 *J T Medina* *Wintona*
 date well completed firm name county well located

LANDOWNER:
Mason Cobb
New Albany
 (mailing address)

description of formations encountered	from	to
<i>red clay</i>	<i>0</i>	<i>18</i>
<i>blue "</i>	<i>18</i>	<i>112</i>
<i>rock & sand</i>	<i>112</i>	<i>165</i>

WELL LOCATION:
 sec. *31* T. *6* S. R. *4* E
5 miles *E* of *New Albany*
 (distance) (direction) (nearest town)

WELL PURPOSE:
 (home, irrigation, municipal, industrial)

CODED

WELL COMPLETION DATA:

- (1) diameter (inches) *4*
- (2) total depth (feet) *164*
- (3) static water level (feet) _____ below/above top of ground.
- (4) casing *P* *65*
 (material) (depth)
- _____ if telescope see back.
 (size)
- (5) screen *0* _____
 (length) (depth to top)
- _____ (size) _____ (material)
- (6) pump *1* *5*
 (HP) (yield gpm)
- _____ (type power)
- (7) electric log _____
 (yes or no)
- _____ (organization running log)
- (8) how well bottom plugged _____


AUG 22 1973

DRILLERS REMARKS:

MIS
 2-2-73

If well telescopes please sketch and show depths.

GROUND LEVEL

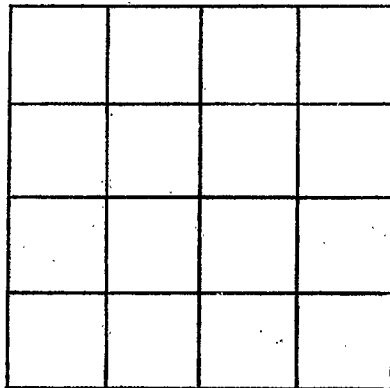

SECTION _____

Please indicate well location X.

ADDITIONAL INFORMATION

If more than one screen, show locations of each on sketch.