

UNION
D24
6/81
Eng 435

MISSISSIPPI
BOARD OF WATER COMMISSIONERS
416 North State Street
Jackson, Mississippi 39201
GWR 516
WATER WELL DRILLERS LOG

CODED

1981 J. W. WEBBSONS UNION
date well completed firm name county well located

LANDOWNER: KEOWNVILLE
WATER ASSOC

description of fomations encountered	from	to
CLAY	0	20
SANDY CLAY	20	100
SAND & CLAY	100	200
BLUE CLAY	200	570
SAND	570	640

(mailing address)
WELL LOCATION:
sec 20 T 65 S R 14 E
6 miles EAST of NEW ALBANY
(distance) (direction) (nearest town)

CODED

WELL PURPOSE:
(home, irrigation, municipal, industrial)

WELL COMPLETION DATA:

- (1) diameter (inches) 10"
- (2) total depth (feet) 640
- (3) static water level (feet) 127 below top of ground
- (4) casing STEEL 559' (material), (depth)
- (size) If telescope see back.
- (5) screen 60 545 (length), (depth to top)
6" 55 (size), (material)
- (6) pump 40 200 (HP), (yield gpm)
ELEC (type power)
- (7) electric log YES (yes or no)
STATE (organization running log)
- (8) how well bottom plugged


DRILLERS REMARKS:

MISSISSIPPI DEPARTMENT OF LAND & WATER RESOURCES
JUN 15 1981
RECEIVED

(X)

If well telescopes please sketch and show depths.

GROUND LEVEL

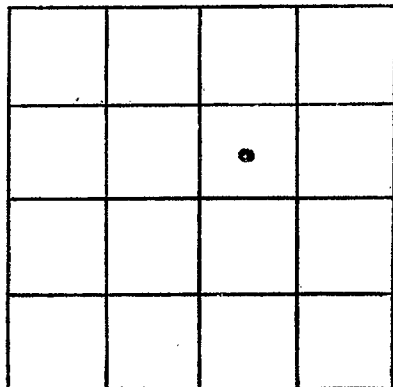

SECTION _____

Please indicate well location X.

ADDITIONAL INFORMATION

If more than one screen,
show locations of each on sketch.