

MISSISSIPPI DEPARTMENT OF ENVIRONMENTAL QUALITY

Office of Land and Water Resources

P. O. Box 10631
Jackson, MS 39289-0631
WATER WELL DRILLERS LOG

COUNTY WELL LOCATED
Union

WELL NUMBER
D-26

CODED

PERMIT NUMBER

NAME OF DRILLING FIRM
Medlin

DATE WELL COMPLETED
3-7-02

NAME & MAILING ADDRESS OF LANDOWNER
Brad Albrecht

1218 CR 146
Keownville MS

Latitude:
Longitude: ⓓ

WELL LOCATION: SEC 7 TOWNSHIP 6 RANGE 4 (S) (E) (W)

DISTANCE 2.5 Miles DIRECTION NW NEAREST TOWN Keownville

OTHER LANDMARK
Little TALLAHACHEE River

WELL PURPOSE (Home) Irrigation, Municipal, Industrial, Fish Pond, etc.

PUMP DATA

PUMP TYPE (Circle One):
Submersible Turbine, Jet, Flowing Well,
Other (Describe)

POWER TYPE (Circle One):
Electric Tractor, Diesel, Gasoline, 3 Butane,
Other (Describe) H/P 4

DESCRIPTION OF FORMATIONS ENCOUNTERED	FROM	TO
<u>clay to top soil</u>	<u>0</u>	<u>100</u>
<u>Blue Clay</u>		
<u>Shell Rock</u>	<u>100</u>	<u>340</u>
<u>aquifer sand</u>		
<u>Shell Rock</u>	<u>340</u>	<u>400</u>

RECEIVED
FEB 07 2003
BY: OIWR
Top of Lap Pipe or Reduction in Casing
FEET IF TELESCOPED OR MORE THAN ONE SCREEN: USE BACK PAGE

WELL DATA

Well Depth <u>400</u>	Casing Diameter (In.) <u>4</u>	Casing Length (Ft.) <u>280</u>
Type of Casing <u>PVC</u>	Hole Depth <u>400</u>	Depth to Static Water Level <u>80</u>

TYPE OF COMPLETION: (Circle One or More):
Gravel Packed, Underreamed, Telescoped,
Natural Development, Open Hole, Other (Describe)

WELL GROUTED TO A DEPTH OF 10 FEET
Type Grout (circle one): Cement, Bentonite, or Mix

SCREEN DATA

Diameter - Inches <u>2</u>	Length - Feet <u>60</u>	Slot Size - Inches <u>0.13</u>
Screen Type <u>PVC</u>	Depth to Bottom - Feet <u>340 - 400</u>	

I certify that the well was drilled, constructed and completed in accordance with all applicable Requirements of the Mississippi Department of Environmental Quality and/or the Mississippi Department of Health regulations and state laws.


James R. Mell 0-429
Signature of Licensed Driller and License No.

3-7-02
today 2-5-03
Date

Additional Information Required On Back

If well telescopes please sketch and show depths.

GROUND LEVEL

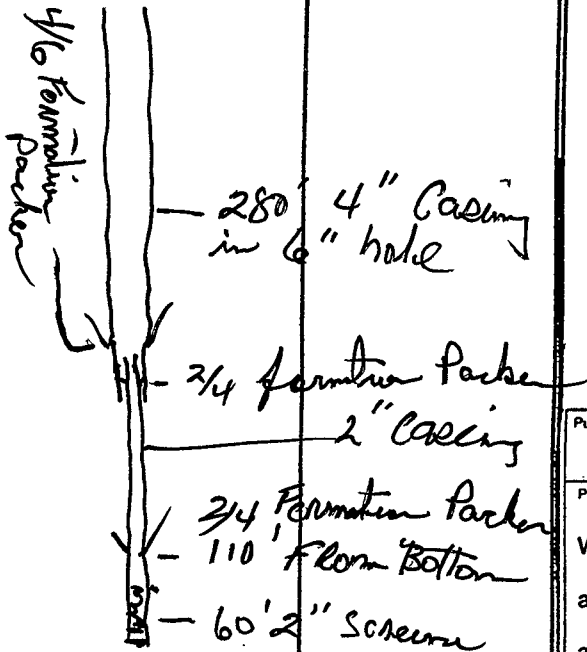

Pump Ca

11

PUMP

Well

a dra

after

TYPE

Elect

Othe

Name

th

ft.

ng

un.

ron.

Surface Elev.	Geologic Unit	Unit Thickness	Depth to Top
Subs. SWL	Date	Analysis	Aquifer Test

Driller's Remarks

If more than one screen, show location of each on sketch.