

UNION  
D 2000  
3-18-77

MISSISSIPPI  
BOARD OF WATER COMMISSIONERS  
416 North State Street  
Jackson, Mississippi 39201

WATER WELL DRILLERS LOG

3-18 1977 Medlin Well Drilling Clifton  
date well completed firm name county well located

LANDOWNER: Hershel  
Burks  
NEW Albany Ms.  
(mailing address)

description of formations encountered	from	to
<u>Clay</u>	<u>0</u>	<u>35</u>
<u>mixed clay</u>	<u>35</u>	<u>60</u>
<u>Blue clay</u>	<u>60</u>	<u>175</u>
<u>sand &amp; rock</u>	<u>175</u>	<u>230</u>

WELL LOCATION:  
sec. 4 T 6 N ? R 4 E  
10 miles EAST of NEW Albany  
(distance) (direction) (nearest town)

WELL PURPOSE:  
(home, irrigation, municipal, industrial)

- WELL COMPLETION DATA:
- (1) diameter (inches) 4"
  - (2) total depth (feet) 230'
  - (3) static water level (feet) 70 <sup>below</sup> <sub>above</sub> top of ground.
  - (4) casing Plas. 120'  
(material) (depth)
  - \_\_\_\_\_ If telescope see back.  
(size)
  - (5) screen \_\_\_\_\_  
(length) (depth to top)
  - (size) \_\_\_\_\_ (material)
  - (6) pump 1/2 8  
(HP) (yield gpm)
  - Elec.  
(type power)
  - (7) electric log \_\_\_\_\_  
(yes or no)
  - \_\_\_\_\_ (organization running log)
  - (8) how well bottom plugged OPEN.


DRILLERS REMARKS:

RECEIVED  
AUG 22 1977

MISS. BD. OF WATER CL.

If well telescopes please  
sketch and show depths.

GROUND LEVEL

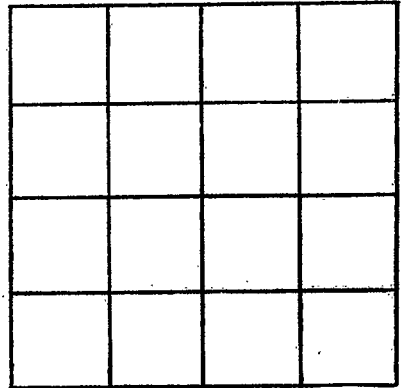

SECTION \_\_\_\_\_

Please indicate well location X.

ADDITIONAL INFORMATION

If more than one screen,  
show locations of each on sketch.