

Union
E 9
6-18-71

MISSISSIPPI
 BOARD OF WATER COMMISSIONERS
 416 North State Street
 Jackson, Mississippi 39201

712.50
 37.50
 \$750.00
CODED

WATER WELL DRILLERS LOG

June 18 19 71 J. T. Madkin UNION
 date well completed firm name county well located

LANDOWNER: FEH
Iron Key Kendall
Pleasant Ridge #W 30
 (mailing address)

description of formations encountered	from	to
<u>Red clay</u>	<u>0</u>	<u>12</u>
<u>" sand</u>	<u>12</u>	<u>50</u>
<u>Yellow clay</u>	<u>50</u>	<u>68</u>
<u>sand</u>	<u>68</u>	<u>99</u>
<u>Blue clay</u>	<u>99</u>	<u>120</u>

WELL LOCATION:
 sec. 6 T. 6 N. R. 5 E
2 miles NE of Pleasant Ridge
 (distance) (direction) (nearest town)

WELL PURPOSE:
 (home, irrigation, municipal, industrial)

- WELL COMPLETION DATA:
- (1) diameter (inches) 4
 - (2) total depth (feet) 120
 - (3) static water level (feet) 23 below above top of ground.
 - (4) casing P 120
 (material) (depth)
 (size) if telescope see back.
 - (5) screen 10 85
 (length) (depth to top)
4 P
 (size) (material)
 - (6) pump 15 6
 (HP) (yield gpm)
E.
 (type power)
 - (7) electric log (yes or no)
 - (organization running log)
 - (8) how well bottom plugged Cap

CODED


JUL 6 1971

DRILLERS REMARKS:

MISS. BU. OF
 WATER CURRERS

If well telescopes please sketch and show depths.

GROUND LEVEL

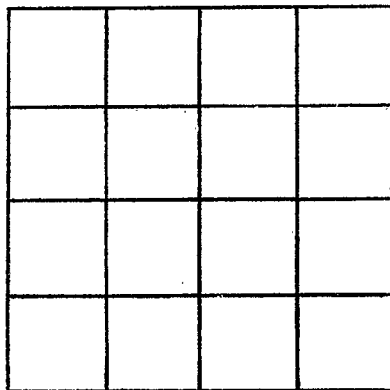

SECTION _____

Please indicate well location X.

ADDITIONAL INFORMATION

If more than one screen,
show locations of each on sketch.