

CODED

MISSISSIPPI
BOARD OF WATER COMMISSIONERS
416 North State Street
Jackson, Mississippi 39201

WATER WELL DRILLERS LOG

CODED

Union
E 10,
5-26-69

May 26 19 69 J. W. Wellborn

date well completed

firm name

county well located

LANDOWNER: Tom Bennett

Jerico, Miss

(mailing address)

description of formations encountered

from

to

Clay & sand	0	30
Blue marl	30	300
Waty sand	300	410
Blue marl	410	420

WELL LOCATION:

sec. 34 T 65 N R 5 E
12 West S Baldwyn
3 miles NW of Jerico
(distance) (direction) (nearest town)

WELL PURPOSE: home
(home, irrigation, municipal, industrial)

WELL COMPLETION DATA:

- (1) diameter (inches) 5
- (2) total depth (feet) 420
- (3) static water level (feet) 180 below top of ground.
- (4) casing steel 41 (material), (depth)
- (size) if telescope see back.
- (5) screen none (length), (depth to top)
- (size) (material)
- (6) pump 1/2 8 (HP) (yield gpm)
- electric (type power)
- (7) electric log no (yes or no)
- (organization running log)

CODED

(8) how well bottom plugged


DRILLERS REMARKS:

JUL 9 - 1969

MISS. BD. OF
WATER COMM.

If well telescopes please sketch and show depths.

GROUND LEVEL

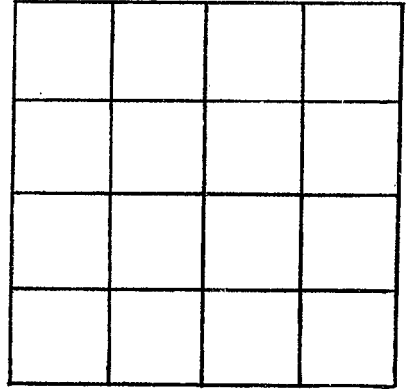

SECTION 34

Please indicate well location X.

ADDITIONAL INFORMATION

If more than one screen,
show locations of each on sketch.