

Union  
E 11.  
5-28-69

MISSISSIPPI  
BOARD OF WATER COMMISSIONERS  
416 North State Street  
Jackson, Mississippi 39201

CODED

WATER WELL DRILLERS LOG

CODED

5-28 1969 J. W. Webb & Sons Union  
date well completed firm name county well located

LANDOWNER: Miles McDonald

description of formations encountered from to

Buntown Miss  
(mailing address)

Soil	0	4
White Rock	6	34
Blue Rock	34	220
Water sand	220	440
Coarse		

WELL LOCATION:  
sec. 34 T 65 N R. 5 E  
S W  
12 miles west of Baldwyn  
(distance) (direction) (nearest town)

WELL PURPOSE:  
(home, irrigation, municipal, industrial)

WELL COMPLETION DATA:

- (1) diameter (inches) 5
- (2) total depth (feet) 440
- (3) static water level (feet) 181 below above top of ground.
- (4) casing steel, 4 1/2" (material), (depth)  
5 (size) if telescope see back.
- (5) screen (length) (depth to top)  
(size) (material)
- (6) pump 1/2 HP, 8 (HP) (yield gpm)  
Elec (type power)
- (7) electric log (yes or no)  
(organization running log)
- (8) how well bottom plugged

CODED


JUL 9 1969

DRILLERS REMARKS:

MISS. BD. OF

If well telescopes please sketch and show depths.

GROUND LEVEL

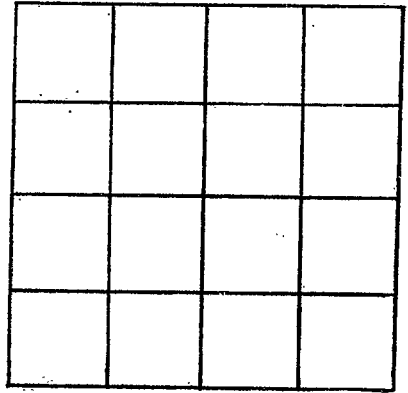

SECTION 34

Please indicate well location X.

ADDITIONAL INFORMATION

Lined area for additional information.

If more than one screen, show locations of each on sketch.