

Union
E 13
6-26-70

MISSISSIPPI
BOARD OF WATER COMMISSIONERS
416 North State Street
Jackson, Mississippi 39201

CODED

WATER WELL DRILLERS LOG

626 1970 J.T. Madlin U.M.W. date well completed firm name county well located

LANDOWNER: Elmer Martin

description of formations encountered

from to

BOONEVILLE R# 3
(mailing address)

<u>Red Clay</u>	<u>0</u>	<u>18</u>
<u>" Sand</u>	<u>18</u>	<u>36</u>
<u>Rock</u>	<u>36</u>	<u>37</u>
<u>Sand</u>	<u>37</u>	<u>67</u>
<u>Yellow Clay</u>	<u>67</u>	<u>72</u>
<u>1 sand</u>	<u>72</u>	<u>108</u>
<u>Clay</u>	<u>108</u>	<u>112</u>

WELL LOCATION: S
sec. 16 T. 6 R. 5
3 miles E of Pharos
(distance) (direction) (nearest town)

WELL PURPOSE:
(home, irrigation, municipal, industrial)

WELL COMPLETION DATA:

- (1) diameter (inches) 4
- (2) total depth (feet) 110
- (3) static water level (feet) 90 below above top of ground.
- (4) casing P 110
(material) (depth)
 If telescope see back.
(size)
- (5) screen 20 90
(length) (depth to top)
 (size) (material)
- (6) pump 1 14
(HP) (yield gpm)
E
(type power)
- (7) electric log (yes or no)
(organization running log)
- (8) how well bottom plugged

CODED


JUL 1 1970

MISS. BD. OF
WATER COMM.

DRILLERS REMARKS:

If well telescopes please sketch and show depths.

GROUND LEVEL

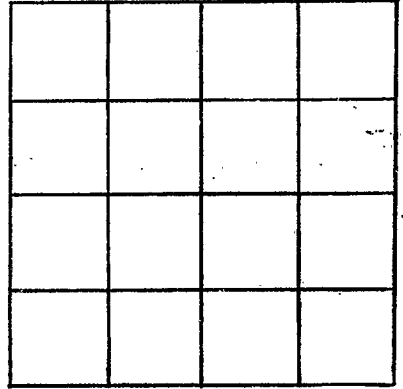

SECTION _____

Please indicate well location X.

ADDITIONAL INFORMATION

If more than one screen, show locations of each on sketch.