

UNION
E14
10-5-70

MISSISSIPPI
BOARD OF WATER COMMISSIONERS
416 North State Street
Jackson, Mississippi 39201

CODED

WATER WELL DRILLERS LOG

Oct 5 1970 J.W. Webb & Sons Union
date well completed firm name county well located

LANDOWNER: <u>Pale Wilbanks</u>	description of formations encountered	from	to
<u>Hunttown miss.</u> (mailing address)	<u>Soil</u>	0	5
	<u>Bumbo</u>	5	37
	<u>Blue Rock</u>	97	303
	<u>Water Rock</u>	303	305
	<u>Water Sand</u>	305	430
	<u>Coffee Sand</u>		

CODED


NOV 16 1970

MISS. BD. OF
WATER COMM.

If well telescopes please sketch and show depths.

92
61

GROUND LEVEL

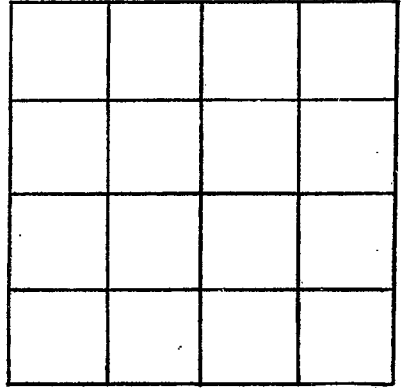

SECTION _____

Please indicate well location X.

ADDITIONAL INFORMATION

If more than one screen,
show locations of each on sketch.