

UNION
E16
10-27-71

MISSISSIPPI
BOARD OF WATER COMMISSIONERS
416 North State Street
Jackson, Mississippi 39201

650.00
101 32.50
182.50
CODER
W.M.W.

WATER WELL DRILLERS LOG

CODER

10 27 1971 date well completed
J & T Medlin firm name
W.M.W. county well located

LANDOWNER: <u>Mr. Ker Kendall</u>	description of formations encountered	from	to
<u>Pleasant Ridge</u>			
	<u>Red Sand</u>	<u>45</u>	<u>120</u>

(mailing address)

WELL LOCATION:
sec. 5 T 6 N R 5 E
S W
2 miles NE of Pleasant Ridge
(distance) (direction) (nearest town)

WELL PURPOSE:
(home, irrigation, municipal, industrial)

- WELL COMPLETION DATA:
- (1) diameter (inches) 4
 - (2) total depth (feet) 120
 - (3) static water level (feet) 75 below above top of ground.
 - (4) casing P 120
(material) (depth)
 if telescope see back.
(size)
 - (5) screen 10 110
(length) (depth to top)
4 P
(size) (material)
 - (6) pump 3/4 4
(HP) (yield gpm)
E
(type power)
 - (7) electric log
(yes or no)

(organization running log)
 - (8) how well bottom plugged

CODER


NOV 16 1971

MISS. BD. OF
WATER COM.

DRILLERS REMARKS:

If well telescopes please sketch and show depths.

GROUND LEVEL

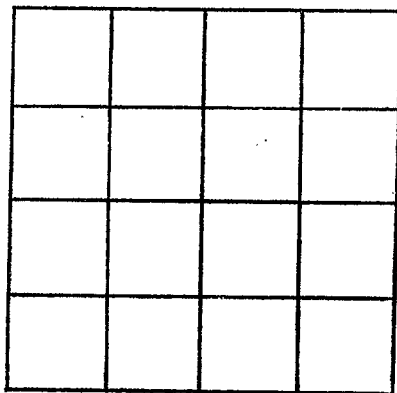

SECTION _____

Please indicate well location X.

ADDITIONAL INFORMATION

If more than one screen,
show locations of each on sketch.