

E 20

UNION

8-14-63

WATER WELL DRILLERS LOG

CODED

Union

Date: 4/14, 1963, Driller: HERNDON WELL & SUPPLY, P.O. BOX #2, SHANNON, MISSISSIPPI, County: Union

(1) Owner of Land:	Description & Color of Materials	Thick-ness Feet	Depth Feet
Hugh Lowell <small>(Name)</small> Rt 2, Bollinger, Miss <small>(Address)</small>	uniform sand & clay		0
Location: 1/4, 1/4, Sec 16 T. R. 4 4 miles W. of Beeville <small>(distance) (direction) (Nearest Town)</small>	Blue sand &		40
Topography: Hilly <small>(Hilly) (Flat) (Level)</small>	sand &		260
Purpose of Well: Domestic <small>(Domestic Irrigation Municipal, Industrial, Other)</small>	Bottom		380

Information upon completion of well:


- (1) Diameter 9 inches.
- (2) Total Depth 340 feet.
- (3) Water Level 120 feet below top of ground.
- (4) Cased to 42', Size 5"
- (5) Screen: Size —, Length —.
- (6) Were any formations sealed against pollution?  
 yes,  no.

If YES depth of formation 40'

Why uniform & sand

Drillers Remarks:

CODED

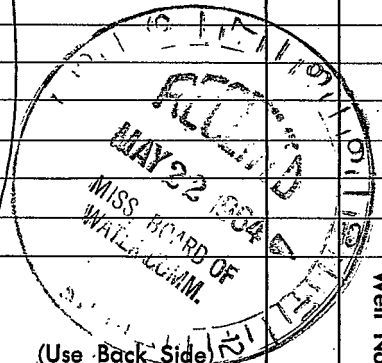

Well No.

(Use Back Side)

1000

1000

1000