


2

If well telescopes please sketch and show depths.

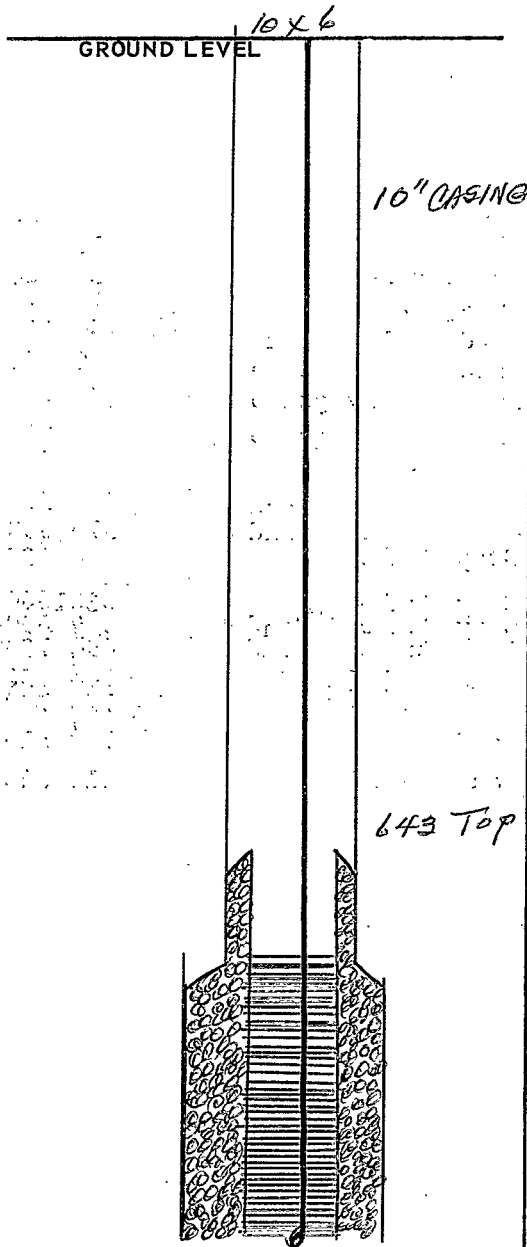

X			

SECTION 7

Please indicate well location X.

ADDITIONAL INFORMATION

643 Top of LAP
 63' Lap pipe - 6"
 406' casing
 25' screen - Johnson 6"
 57' Blank
 30' Screen " "
 818' Bottom Screen

If more than one screen, show locations of each on sketch.