

MISSISSIPPI
 WATER COMMISSIONERS
 1015 State Street
 Jackson, Mississippi 39201

WELL DRILLERS LOG

Well Drilling
 firm name

Producers Union
 county well located

LANDOWNER: Harry Old

Baldwyn

(mailing address)

description of formations encountered

from to

<u>Red Clay</u>	<u>0</u>	<u>15</u>
<u>Blue Clay</u>	<u>15</u>	<u>150</u>
<u>Water Sand</u>	<u>150</u>	<u>195</u>

WELL LOCATION:

sec. 11 T. 6 N. R. 5 E
 (S) (W)
10 miles W of Baldwyn
 (distance) (direction) (nearest town)

WELL PURPOSE: Home
 (home, irrigation, municipal, industrial)

WELL COMPLETION DATA:

- (1) diameter (inches) 4"
- (2) total depth (feet) 195
- (3) static water level (feet) 60 ^{below} above top of ground.
- (4) casing Plastic, 20
 (material) (depth)
 (size) if telescope see back.
- (5) screen no
 (length) (depth to top)
 (size) (material)
- (6) pump 3/4 10 gpm
 (HP) (yield gpm)
elect
 (type power)
- (7) electric log no
 (yes or no)
 (organization running log)
- (8) how well bottom plugged open


DRILLERS REMARKS:

RECEIVED
 DEC - 5 1978

MISS. BD. OF WATER COMMISSIONERS

If well telescopes please sketch and show depths.

GROUND LEVEL

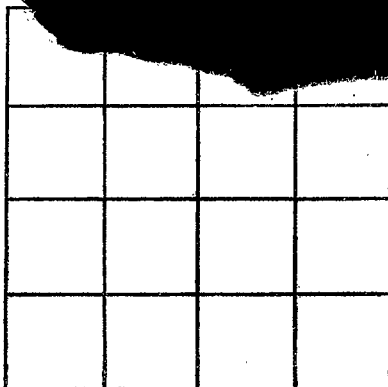

SECTION _____

Please indicate well location X.

ADDITIONAL INFORMATION

If more than one screen, show locations of each on sketch.