

Union
F 10
10-66

MISSISSIPPI
BOARD OF WATER COMMISSIONERS
416 North State Street
Jackson, Mississippi 39201

CODED
CODED

WATER WELL DRILLERS LOG

Oct. 5 1966 Temper Woods Union
date well completed firm name county well located

LANDOWNER:
Henry King
New Albany Miss
(mailing address)

description of formations encountered	from	to
<u>Mud Clay (Sand)</u>	<u>0</u>	<u>40</u>
<u>Clay</u>	<u>40</u>	<u>340</u>
<u>Sand & Rock</u>	<u>340</u>	<u>400</u>

WELL LOCATION:
23 sec. 4 T. 3 N. R. 1 E
10 miles South of New Albany
(distance) (direction) (nearest town)

WELL PURPOSE:
(home, irrigation, municipal, industrial)

WELL COMPLETION DATA:

(1) diameter (inches) 4

(2) total depth (feet) 400

(3) static water level (feet) 20 below top of ground.

(4) casing Steel 60, 4" (material) (depth)
4" if telescope see back. (size)

(5) screen none (length) (depth to top)
(size) (material)

(6) pump 1/4 8 (HP) (yield gpm)
electric (type power)

(7) electric log no (yes or no)
(organization running log)

(8) how well bottom plugged None

DRILLERS REMARKS:

CODED

CODED


CODED

DEC 10 1968

MISS. BD. OF WATER COMMISSIONERS

If well telescopes please sketch and show depths.

GROUND LEVEL

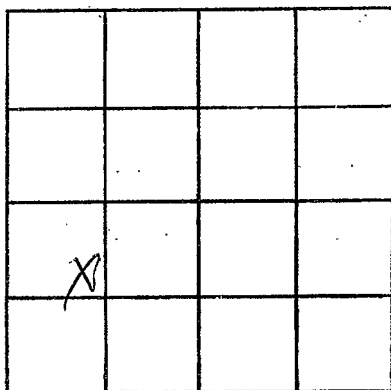

SECTION 21

Please indicate well location X.

ADDITIONAL INFORMATION

If more than one screen, show locations of each on sketch.