

Union
F 11
6-69

MISSISSIPPI
BOARD OF WATER COMMISSIONERS
416 North State Street
Jackson, Mississippi 39201

CODED

WATER WELL DRILLERS LOG

6 18 19 69 J. T. Mullen Union Co.
date well completed firm name county well located

LANDOWNER: C. P. D. [unclear]

description of formations encountered

from to

New Orleans
(mailing address)

Clay 0 19
Blue clay 19 160
rock 160 270

WELL LOCATION:

sec. 2 T 7 N R 1 E
4 miles of New Orleans
(distance) (direction) (nearest town)

WELL PURPOSE:

(home, irrigation, municipal, industrial)

WELL COMPLETION DATA:

- (1) diameter (inches) 4
- (2) total depth (feet) 270
- (3) static water level (feet) 60 below top of ground
- (4) casing (material) P (depth) 80 (size) 4 If telescope see back.
- (5) screen (length) (depth to top) (size) (material)
- (6) pump (HP) 34 (yield gpm) 6 (type power) C
- (7) electric log (yes or no) (organization running log)
- (8) how well bottom plugged

CODED


APR 14 1969

DRILLERS REMARKS:

Mississippi Board of Water Commissioners

If well telescopes please sketch and show depths.

GROUND LEVEL

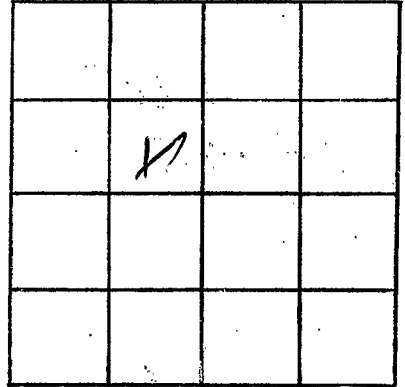

SECTION _____

Please indicate well location X.

ADDITIONAL INFORMATION

If more than one screen, show locations of each on sketch.