

UNION
F12
1-28-70

MISSISSIPPI
BOARD OF WATER COMMISSIONERS
416 North State Street
Jackson, Mississippi 39201

CODED

WATER WELL DRILLERS LOG

1-28-1970 date well completed
J. W. Webb & Sons firm name
Union county well located

LANDOWNER: Frank Watson

description of formations encountered	from	to
Soil	0	16
Humus	16	54
Blue sand & Clay	54	89
Blue Rock	89	303
Water Sand & Rocks	303	410
Ripley		

myrtle miss (mailing address)

WELL LOCATION:
sec. 13 T 45 N R 1 E
S W
7 miles west of New Albany
(distance) (direction) (nearest town)

WELL PURPOSE:
(home, irrigation, municipal, industrial)

WELL COMPLETION DATA:

- (1) diameter (inches) 4
- (2) total depth (feet) 410
- (3) static water level (feet) 90 below top of ground.
- (4) casing steel, 147 (material), (depth)
4 (size) if telescope see back.
- (5) screen 0 (length), (depth to top)
(size), (material)
- (6) pump Rod pump 3 (HP), (yield gpm)
Elec (type power)
- (7) electric log (yes or no)
(organization running log)
- (8) how well bottom plugged


Feb. 2 - 1970

MISS. Bd. OF WATER COM. LOG

DRILLERS REMARKS:

If well telescopes please sketch and show depths.

GROUND LEVEL

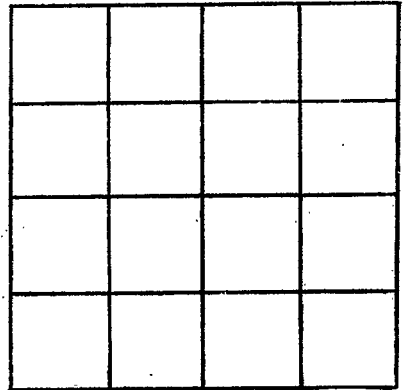

SECTION _____

Please indicate well location X.

ADDITIONAL INFORMATION

If more than one screen,
show locations of each on sketch.