

CODED

UNION
F13
1-5-70

MISSISSIPPI
BOARD OF WATER COMMISSIONERS
416 North State Street
Jackson, Mississippi 39201

WATER WELL DRILLERS LOG

1-5-70
date well completed

Juniper Well Co.
firm name

Union
county well located

LANDOWNER:
Jimmy Baker
New Albany Miss.
(mailing address)

description of formations encountered	from	to
<i>mixed clay</i>	<i>0</i>	<i>100</i>
<i>clay</i>	<i>100</i>	<i>400</i>
<i>Rock + Sand</i>	<i>400</i>	<i>550</i>

WELL LOCATION:
sec. *6* T. *7* N. R. *1* E
10 miles *SW* of *New Albany*
(distance) (direction) (nearest town)

WELL PURPOSE: *home*
(home, irrigation, municipal, industrial)

- WELL COMPLETION DATA:
- (1) diameter (inches) *4*"
 - (2) total depth (feet) *550*
 - (3) static water level (feet) *70* below top of ground.
 - (4) casing *PVC*, *120*,
(material) (depth)
0 if telescope see back.
(size)
 - (5) screen *0*, *0*
(length) (depth to top)
0, *0*
(size) (material)
 - (6) pump *3/4*, *10*
(HP) (yield gpm)
Elec.
(type power)
 - (7) electric log *0*
(yes or no)
0
(organization running log)
 - (8) how well bottom plugged *0*

CODED


FEB 18 1970

DRILLERS REMARKS:

MISS. SD. G.
WATER

If well telescopes please sketch and show depths.

GROUND LEVEL

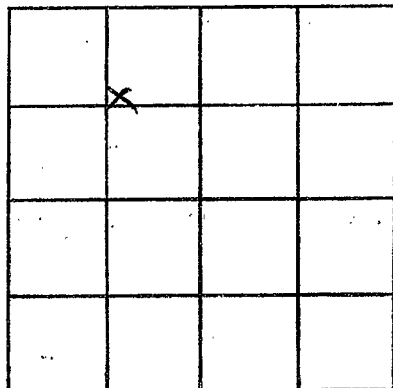

SECTION 6

Please indicate well location X.

ADDITIONAL INFORMATION

If more than one screen, show locations of each on sketch.