

Union
 F 14
 3-2-70

MISSISSIPPI
 BOARD OF WATER COMMISSIONERS
 416 North State Street
 Jackson, Mississippi 39201

CODED

WATER WELL DRILLERS LOG

3-2 1970 Ed Clark Co. Union
 date well completed firm name county well located

LANDOWNER:
 Laverne Bairfield
 Etta Louie
 (mailing address)

description of formations encountered	from	to
Red Clay	0	20
Blue mud	20	60
Rock & Sand	60	100
Blue mud	100	190
Rock	190	220
Blue mud	220	410
Rock & Sand	410	540
Blue mud	540	560
Rock & Sand	560	638

WELL LOCATION:
 sec. 31 T 7 N R 1 E
 5 miles S of Etta
 (distance) (direction) (nearest town)

WELL PURPOSE: Home
 (home, irrigation, municipal, industrial)

WELL COMPLETION DATA:

- (1) diameter (inches) 4"
- (2) total depth (feet) 638'
- (3) static water level (feet) 90' below above top of ground.
- (4) casing Metal 105' (material) (depth)
 4" (size) If telescope see back.
- (5) screen None (length) (depth to top)
 (size) (material)
- (6) pump Rod 3/4 7 (HP) (yield gpm)
 Electric (type power)
- (7) electric log no (yes or no)
- (8) how well bottom plugged no
 (organization running log)

CODED


APR 20 1970

MISS. BD. OF
 WATER COMM.

DRILLERS REMARKS:

If well telescopes please
sketch and show depths.

GROUND LEVEL

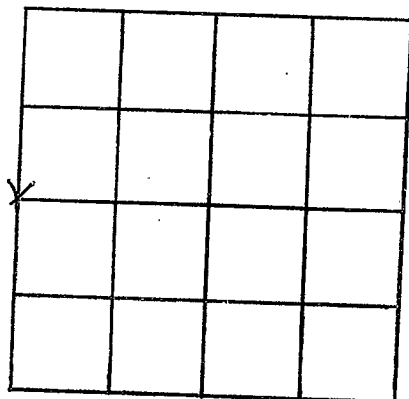

SECTION _____

Please indicate well location X.

ADDITIONAL INFORMATION

If more than one screen,
show locations of each on sketch.