

UNION  
F16  
11-25-70

MISSISSIPPI  
BOARD OF WATER COMMISSIONERS  
416 North State Street  
Jackson, Mississippi 39201

**CODED**

WATER WELL DRILLERS LOG

Nov. 25 1970 Clark Bros. Union  
date well completed firm name county well located

LANDOWNER:  
David Ray Williams  
Route 4, New Albany  
(mailing address)

description of formations encountered	from	to
Shingles	0	20
Rock & sand	20	50
blue mud	50	200
Rock & sand	200	250

WELL LOCATION:  
sec. 35 T 07 N R 1 E  
12 miles SW of New Albany  
(distance) (direction) (nearest town)

WELL PURPOSE:  
Home  
(home, irrigation, municipal, industrial)

- WELL COMPLETION DATA:
- (1) diameter (inches) 4"
  - (2) total depth (feet) 250'
  - (3) static water level (feet) 40' below top of ground.
  - (4) casing Metal 84' (material) (depth)  
4" (size) if telescope see back.
  - (5) screen none (length) (depth to top)  
(size) (material)
  - (6) pump 1 1/2 HP 6 (type power) (yield gpm)  
Electric (type power)
  - (7) electric log no (yes or no)  
(organization running log)
  - (8) how well bottom plugged no

**CODED**


JAN 4 - 1971

MISS. BD. OF  
WATER COMM.

DRILLERS REMARKS:

If well telescopes please sketch and show depths.

GROUND LEVEL

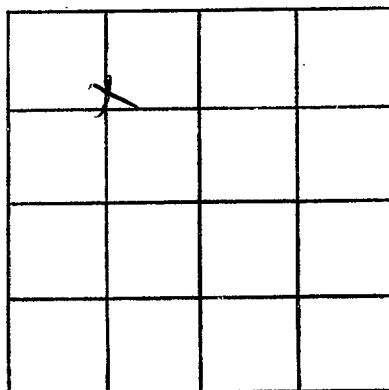

SECTION \_\_\_\_\_

Please indicate well location X.

ADDITIONAL INFORMATION

If more than one screen, show locations of each on sketch.