

UNION
F18
5-21-71

MISSISSIPPI
BOARD OF WATER COMMISSIONERS
416 North State Street
Jackson, Mississippi 39201

831 25
43 75
875 00

WATER WELL DRILLERS LOG

CODED

May 21 1971 *JT Madlin*
date well completed firm name county well located

| LANDOWNER: | description of formations encountered | from | to |
|--|---------------------------------------|------|----|
| <i>B. J. Doolin</i> <i>Ette Miss</i> (mailing address) | | | |

WELL LOCATION:
sec. 20 T 7 N R 1 E
3 miles SW of Ette
(distance) (direction) (nearest town)

WELL PURPOSE:
(home, irrigation, municipal, industrial)

- WELL COMPLETION DATA:
- (1) diameter (inches) 4
 - (2) total depth (feet) 480
 - (3) static water level (feet) 67 below top of ground.
 - (4) casing P 108
(material) (depth)
(size) if telescope see back.
 - (5) screen _____
(length) (depth to top)
(size) (material)
 - (6) pump 1 5
(HP) (yield gpm)
(type power)
 - (7) electric log _____
(yes or no)
(organization running log)
 - (8) how well bottom plugged _____

CODED


6 1971

DRILLERS REMARKS:

MISS. Bd. of
WATER COM.

If well telescopes please sketch and show depths.

GROUND LEVEL

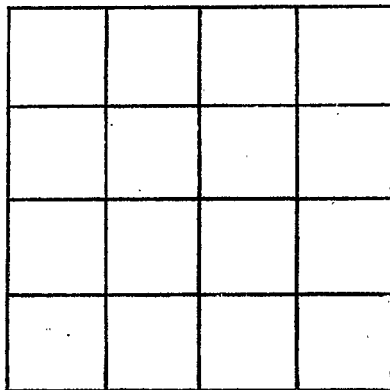

SECTION _____

Please indicate well location X.

ADDITIONAL INFORMATION

A series of 18 horizontal lines provided for writing additional information.

If more than one screen, show locations of each on sketch.