

UNION  
F 20  
9-14-71

MISSISSIPPI  
BOARD OF WATER COMMISSIONERS  
416 North State Street  
Jackson, Mississippi 39201

~~7-14-71~~  
~~24~~  
~~7-14-71~~  
\$ 759.00  
36.00  
423.00

WATER WELL DRILLERS LOG

9 14 1971 date well completed  
J.T. Medley firm name  
COLEMAN county well located

LANDOWNER: Mrs. Carter  
STAR R # M/TLE  
(mailing address)

description of formations encountered	from	to
White clay	0	18
Blue "	18	380
Rock "	380	420
Rock & sand	420	500

WELL LOCATION:  
sec. 5 T 2 N R 1 E  
1/2 miles W of 3 W W G R  
(distance) (direction) (nearest town)

WELL PURPOSE:  
(home, irrigation, municipal, industrial)

- WELL COMPLETION DATA:
- (1) diameter (inches) 4
  - (2) total depth (feet) 500
  - (3) static water level (feet) 35 below above top of ground.
  - (4) casing P 80 (material) (depth)  
(size) if telescope see back.
  - (5) screen 0 (length) (depth to top)  
(size) (material)
  - (6) pump 1 (HP) 9 (yield gpm)  
E (type power)
  - (7) electric log (yes or no)  
(organization running log)
  - (8) how well bottom plugged

**CODED**


OCT 6 - 1971

MISS. BD. OF  
WATER COMMISSIONERS

DRILLERS REMARKS:

If well telescopes please sketch and show depths.

GROUND LEVEL

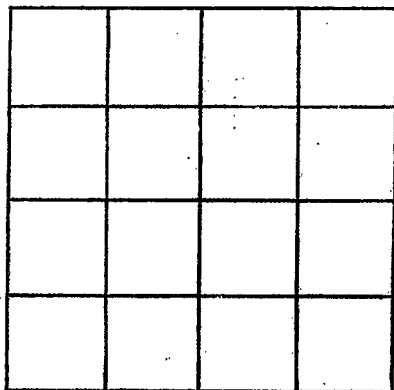

SECTION \_\_\_\_\_

Please indicate well location X.

**ADDITIONAL INFORMATION**

If more than one screen,  
show locations of each on sketch.