

\$ 500.00
TAX CO to 73 2290

CODED

UNION
F 21
9-15-71

MISSISSIPPI BOARD OF WATER COMMISSIONERS
416 North State Street
Jackson, Mississippi 39201

WATER WELL DRILLERS LOG

9 15 19 71 ST Martin UNION
date well completed firm name county well located

LANDOWNER: James C. Black

STAR RIFLE

(mailing address)

description of formations encountered	from	to
<u>White clay</u>	<u>0</u>	<u>18</u>
<u>Blue "</u>	<u>18</u>	<u>370</u>
<u>Rock & clay</u>	<u>370</u>	<u>470</u>
<u>Rock & sand</u>	<u>470</u>	<u>500</u>

WELL LOCATION:

sec. 5 T 2 N R 1 E
S W
3 miles WAY gro of (nearest town)

WELL PURPOSE: SWAY GRO
(home, irrigation, municipal, industrial)

WELL COMPLETION DATA:

- (1) diameter (inches) 4
- (2) total depth (feet) 500
- (3) static water level (feet) 42 below top of ground.
- (4) casing P 81
(material) (depth)
(size) if telescope see back.
- (5) screen 0
(length) (depth to top)
(size) (material)
- (6) pump None
(HP) (yield gpm)
(type power)
- (7) electric log (yes or no)
- (organization running log)
- (8) how well bottom plugged

CODED


OCT 6 - 1971

MISS. Bd. of WATER COMMISSIONERS

DRILLERS REMARKS:

If well telescopes please sketch and show depths.

GROUND LEVEL

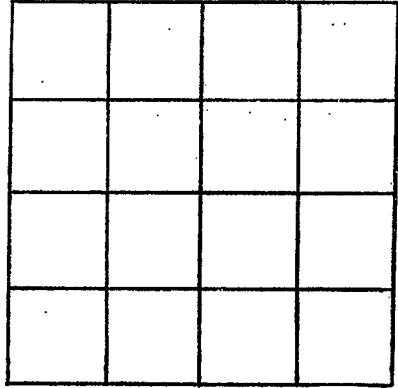

SECTION _____

Please indicate well location X.

ADDITIONAL INFORMATION

A series of horizontal lines for writing additional information.

If more than one screen, show locations of each on sketch.