

# 760.50  
 40.50  
 801.00  
~~857.50~~  
 55.50  
~~810.00~~

MISSISSIPPI  
 BOARD OF WATER COMMISSIONERS  
 416 North State Street  
 Jackson, Mississippi 39201

WATER WELL DRILLERS LOG

**CODED**

UNION  
 F22  
 9-13-71

9-13 1971 date well completed  
 J. T. Madeline firm name  
 county well located

LANDOWNER: Lee Hill  
 GARNISON  
 STAR R# MV-TLE  
 (mailing address)

description of formations encountered	from	to
White Clay	0	12
Bleed cc	12	380
Rock + cc	380	420
Rock & sand	420	500

WELL LOCATION:  
 sec 5 T 2 N R 1 E  
 W  
 1/2 miles W of 3WAY 610  
 (distance) (direction) (nearest town)

WELL PURPOSE:  
 (home, irrigation, municipal, industrial)

- WELL COMPLETION DATA:
- (1) diameter (inches) 4
  - (2) total depth (feet) 500
  - (3) static water level (feet) 35 below top of ground.
  - (4) casing P 78 (material) (depth)
  - (size) if telescope see back.
  - (5) screen 0 (length) (depth to top)
  - (size) (material)
  - (6) pump 1 (HP) 8 (yield gpm)
  - E (type power)
  - (7) electric log (yes or no)
  - (organization running log)
  - (8) how well bottom plugged

**CODED**


OCT 6 - 1971

MISS. DE. OF  
 WATER CONTROL

DRILLERS REMARKS:

If well telescopes please sketch and show depths.

GROUND LEVEL

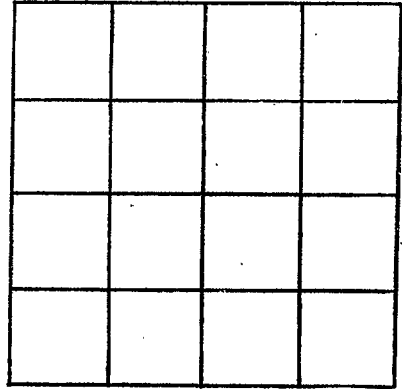

SECTION \_\_\_\_\_

Please indicate well location X.

ADDITIONAL INFORMATION

A series of horizontal lines providing space for additional information.

If more than one screen, show locations of each on sketch.