

Union
F23
11-30-71

MISSISSIPPI
 BOARD OF WATER COMMISSIONERS
 416 North State Street
 Jackson, Mississippi 39201

WATER WELL DRILLERS LOG

CODED

11-30-19 71 *JT Medlin* firm name *Union* county well located

LANDOWNER: *Stodge Hill Well*
Etta Miss
 (mailing address)

Description of formations encountered	from	to
<i>Sand</i>	<i>6</i>	<i>160</i>
<i>Clay</i>	<i>160</i>	<i>493</i>
<i>Rock & Gravel</i>	<i>493</i>	<i>580</i>

WELL LOCATION:
 sec. *30* T *7* N R *1* E
3 miles *S* of *Etta*
 (distance) (direction) (nearest town)

WELL PURPOSE:
 (home, irrigation, municipal, industrial)

- WELL COMPLETION DATA:
- (1) diameter (inches) *4*
 - (2) total depth (feet) *580*
 - (3) static water level (feet) *75* below above top of ground.
 - (4) casing *P* *122*
 (material) (depth)
 (size) If telescope see back.
 - (5) screen *_____* *_____*
 (length) (depth to top)
 (size) (material)
 - (6) pump *1 1/2* *2*
 (HP) (yield gpm)
E
 (type power)
 - (7) electric log (yes or no) _____
 (organization running log) _____
 - (8) how well bottom plugged _____

CODED


JAN 5 1972

MISS. BD. OF
 WATER COMM.

DRILLERS REMARKS:

If well telescopes please sketch and show depths.

GROUND LEVEL

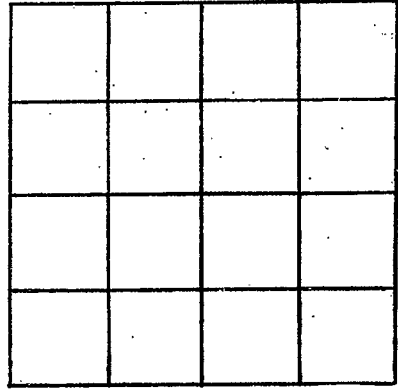

SECTION _____

Please indicate well location X.

ADDITIONAL INFORMATION

If more than one screen, show locations of each on sketch.