

Union  
F25  
B-66

MISSISSIPPI BOARD OF WATER COMMISSIONERS

WATER WELL DRILLERS LOG

**CODED**

Date: 8/15, 1966, Driller: C F CARLISLE County UNION  
(Name)

(1) Owner of Land: ELMER SAUL  
DARDEN LAKE (Name)  
NEW ALBANY MISS.  
 (Address)

(2) Location: SE 1/4, NW 1/4, Sec. 10 T. 1 R. 1 E.  
12 miles W. of NA  
 (distance) (direction) (Nearest Town)

(3) Topography: X  
 (Hilly) (Flat) (Level)


(4) Purpose of Well: DOMESTIC  
 (Domestic Irrigation  
 Municipal, Industrial, Other)

Description & Color of Materials Sand, Clay, Red Clay, Shell, etc.	Thick- ness Feet	Depth Feet
<u>RED CLAY</u>	<u>20</u>	<u>20</u>
<u>BLUE DIRT</u>	<u>300</u>	<u>320</u>
<u>ROCK</u>	<u>10</u>	<u>330</u>
<u>BLUE DIRT</u>	<u>38</u>	<u>368</u>
<u>W ROCK</u>	<u>12</u>	<u>400</u>
<u>W-SAND</u>	<u>40</u>	<u>440</u>

Information upon completion of well:

- (1) Diameter 4 inches.
- (2) Total Depth 440 feet.
- (3) Water Level 40 feet below top of ground.
- (4) Cased to 42, Size 4 in.
- (5) Screen: Size NONE Length \_\_\_\_\_.
- (6) Were any formations sealed against pollution?  
 \_\_\_\_\_ yes, \_\_\_\_\_ no.

**CODED**

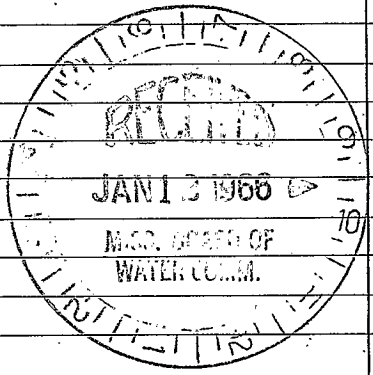

If YES depth of formation \_\_\_\_\_

Why \_\_\_\_\_

Drillers Remarks: \_\_\_\_\_

114

Well No.

(Use Back Side)

