


121

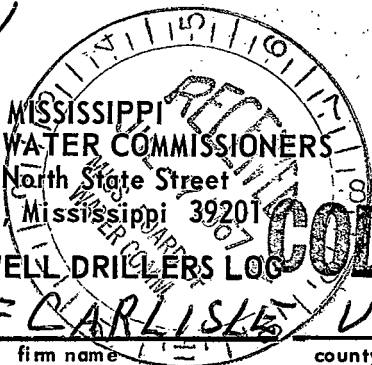

Union  
726  
6-67

BOARD OF WATER COMMISSIONERS  
416 North State Street  
Jackson, Mississippi 39201  
WATER WELL DRILLERS LOG

6-17 1947 CFCARLISKE UNION  
date well completed firm name county well located

LANDOWNER: HC BOGGS

description of formations encountered	from	to
WHITE DIRT	0	22
BLUE	22	23
ROCK	23	32
SAND	32	470
WHITE DIRT	0	22
BLUE DIRT	22	400
ROCK	400	440
SAND	440	470

(mailing address)

WELL LOCATION:

sec. 5 T. 7 N. R. 1 E. S. 4 W.  
14 miles W of N.A.  
(distance) (direction) (nearest town)

WELL PURPOSE:  
(home, irrigation, municipal, industrial)

WELL COMPLETION DATA:

- (1) diameter (inches) 4 in
- (2) total depth (feet) 470
- (3) static water level (feet) 26 below top of ground.
- (4) casing STEEL 84 (material) (depth)
- (size) if telescope see back.
- (5) screen NONE (length) (depth to top)
- (size) (material)
- (6) pump 1/2 (HP) 5 (yield gpm)
- ELECTRIC (type power)
- (7) electric log NO (yes or no)
- (organization running log)
- (8) how well bottom plugged

CODED

DRILLERS REMARKS:

If well telescopes please sketch and show depths.

GROUND LEVEL

X			

SECTION 5

Please indicate well location X.

ADDITIONAL INFORMATION

If more than one screen, show locations of each on sketch.