

122

Union
727
8-67

MISSISSIPPI
BOARD OF WATER COMMISSIONERS
416 North State Street
Jackson, Mississippi 39201

CODED

WATER WELL DRILLERS LOG

8-15 1947 C. F. CARLISLE UNION
date well completed firm name county well located

LANDOWNER: GUY BECKWORTH

description of formations encountered

from to

MVRTLEMISSED.
(mailing address)

WHITE DIRT
BLUE DIRT
ROCK
W SAND

0 72
22 400
400 440
440 470

WELL LOCATION:

sec. 5 T. 7 N. R. 1 E. X
S. W. W. NA
14 miles W of NA
(distance) (direction) (nearest town)

WELL PURPOSE: HOME
(home, irrigation, municipal, industrial)

WELL COMPLETION DATA:

- (1) diameter (inches) 4"
- (2) total depth (feet) 470
- (3) static water level (feet) 32 below above top of ground.
- (4) casing STEEL, 84 (material), (depth)

CODED

(size) If telescope see back.
(5) screen NONE (length) (depth to top)

(size) (material)
(6) pump 1/2 (HP) 5 (yield gpm)

ELECTRIC
(type power)

(7) electric log (yes or no)

(organization running log)


(8) how well bottom plugged

DRILLERS REMARKS:



If well telescopes please sketch and show depths.

GROUND LEVEL

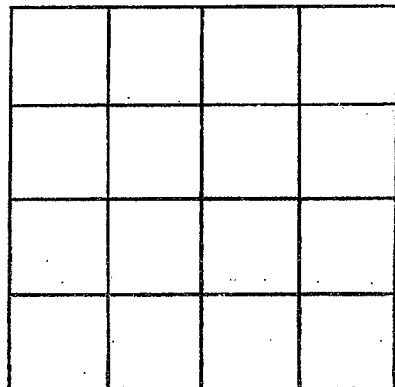

SECTION 5

Please indicate well location X.

ADDITIONAL INFORMATION

If more than one screen, show locations of each on sketch.