

UNION

F28

5-68

MISSISSIPPI  
 BOARD OF WATER COMMISSIONERS  
 416 North State Street  
 Jackson, Mississippi 39201

**CODED**

WATER WELL DRILLERS LOG

5-25 1968  
date well completed

Clark Bros  
firm name

Union  
county well located

LANDOWNER: Kenneth Kirk

Description of formations encountered	from to	
<u>Route</u>		
<u>New Albany</u> (mailing address)		
<u>Jumbo</u>	0	30
<u>Rock &amp; sand</u>	30	50
<u>Blue mud</u>	50	210
<u>Rock &amp; sand</u>	210	240
<u>Blue mud</u>	240	280
<u>Rock &amp; sand</u>	280	308

Route  
New Albany  
 (mailing address)

WELL LOCATION:

sec. 14 T. 7 N. R. 1 E  
 (S) (E)  
9 miles W of New Albany  
 (distance) (direction) (nearest town)

WELL PURPOSE: HOME  
 (home, irrigation, municipal, industrial)

WELL COMPLETION DATA:

- (1) diameter (inches) 4"
- (2) total depth (feet) 308'
- (3) static water level (feet) 14' below above top of ground.
- (4) casing metal 84'  
(material) (depth)  
4"  
(size) if telescope see back.
- (5) screen None  
(length) (depth to top)  
(size) (material)
- (6) pump 3/4 Sub. 14  
(HP) (yield gpm)  
Electric  
(type power)
- (7) electric log NO  
(yes or no)  
(organization running log)
- (8) how well bottom plugged NO


**CODED**

UNION-38-1968  
 MISSISSIPPI  
 WATER COMMISSIONERS

DRILLERS REMARKS:

If well telescopes please sketch and show depths.

GROUND LEVEL

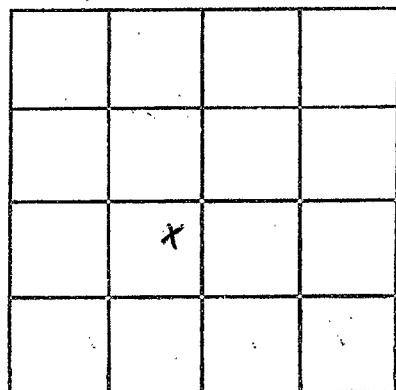

SECTION \_\_\_\_\_

Please indicate well location X.

ADDITIONAL INFORMATION

If more than one screen, show locations of each on sketch.