

**CODED**  
MISSISSIPPI

BOARD OF WATER COMMISSIONERS  
416 North State Street  
Jackson, Mississippi 39201

810 00  
40 50  

---

850 50

**UNION**  
 MISS. BD. O'  
 WATER CO.  
**F-29**  
**1-21-72**  
 121 1972

**WATER WELL DRILLERS LOG**

date well completed 19 72 firm name J T Medlin county well located UNION

LANDOWNER: Bobdy Browning description of formations encountered

|                        | from       | to         |
|------------------------|------------|------------|
| <u>Edta R#</u>         | <u>0</u>   | <u>70</u>  |
| <u>Blue Clay</u>       | <u>70</u>  | <u>490</u> |
| <u>rock &amp; sdsy</u> | <u>490</u> | <u>545</u> |

(mailing address)

WELL LOCATION:  
 sec. 15 T. 7 N. R. 1 E.  
4 miles W. of Enterprise  
 (distance) (direction) (nearest town)

WELL PURPOSE:  
 (home, irrigation, municipal, industrial)

WELL COMPLETION DATA:

(1) diameter (inches) 4

(2) total depth (feet) 545

(3) static water level (feet) 110 below above top of ground.

(4) casing P 80  
 (material) (depth)  
 (size) if telescope see back.

(5) screen \_\_\_\_\_  
 (length) (depth to top)  
 (size) 1/2 (material) 6

(6) pump 2 6  
 (HP) (yield gpm)  
E  
 (type power)

(7) electric log N  
 (yes or no)


(8) how well bottom plugged \_\_\_\_\_

**CODED**

DRILLERS REMARKS:

If well telescopes please sketch and show depths.

GROUND LEVEL

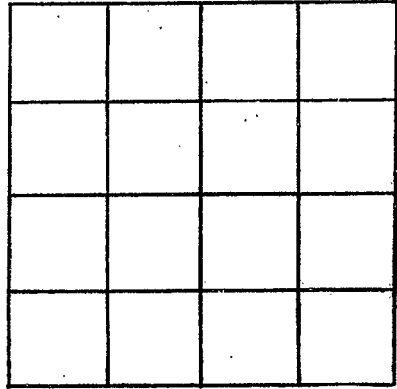

SECTION \_\_\_\_\_

Please indicate well location X.

ADDITIONAL INFORMATION

If more than one screen,  
show locations of each on sketch.