

Union
F 33
9-6-72

MISSISSIPPI
BOARD OF WATER COMMISSIONERS
416 North State Street
Jackson, Mississippi 39201

CODED

WATER WELL DRILLERS LOG

9-6 1972 Ed. Clark Union
date well completed firm name county well located

LANDOWNER:

O. B. Willard

9th Rt-1
(mailing address)

description of formations encountered

from

to

Jumbo	0	20
Blue mud	20	35
Sand & water	35	190
Rock & Sand	190	506

WELL LOCATION:

sec. 8 T 7 S R 1 E
8 miles W of Enterprise
(distance) (direction) (nearest town)

WELL PURPOSE: Home
(home, irrigation, municipal, industrial)

WELL COMPLETION DATA:

- (1) diameter (inches) 4"
- (2) total depth (feet) 506'
- (3) static water level (feet) 25' below top of ground.
- (4) casing Metal 34"
(material) (depth)
4" (size) if telescope see back.
- (5) screen None
(length) (depth to top)
(size) (material)
- (6) pump 3/4 jet 6
(HP) (yield gpm)
Electric
(type power)
- (7) electric log No
(yes or no)
(organization running log)
- (8) how well bottom plugged No

CODED


SEP 20 1972

DRILLERS REMARKS:

MISS. ED. OF
PROPERTY RECORDS

If well telescopes please sketch and show depths.

GROUND LEVEL

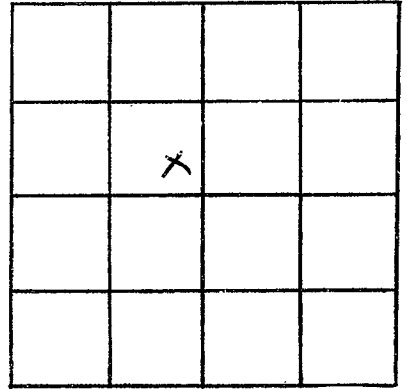

SECTION _____

Please indicate well location X.

ADDITIONAL INFORMATION

If more than one screen, show locations of each on sketch.