

UNION

~~BEAUFORT~~

F 34

8-29-72

MISSISSIPPI  
BOARD OF WATER COMMISSIONERS  
416 North State Street  
Jackson, Mississippi 39201

**CODED**

25600  
750  
78758

WATER WELL DRILLERS LOG

8-29

1972

J.T. Madler  
firm name

~~Beaufort~~  
county well located

LANDOWNER:

~~Washell~~  
Pinedale

description of formations encountered

from to

CLAY  
Blue  
Red & sand

0 45  
45 360  
~~36 400~~  
36 400

(mailing address)

WELL LOCATION:

sec. 34 T. 8 R. 1 E.  
2 miles S of Enterprise

WELL PURPOSE:  
(home, irrigation, municipal, industrial)

WELL COMPLETION DATA:

- (1) diameter (inches) 4
- (2) total depth (feet) 400
- (3) static water level (feet) 6 below top of ground
- (4) casing P 83 (material) (depth)

(size) If telescope see back.

- (5) screen 0 (length) (depth to top)

(size) (material)

- (6) pump 1/2 6 (HP) (yield gpm)

(type power)

- (7) electric log (yes or no)

(organization running log)

- (8) how well bottom plugged


DRILLERS REMARKS:

**CODED**

UGI 12 1972

If well telescopes please sketch and show depths.

GROUND LEVEL

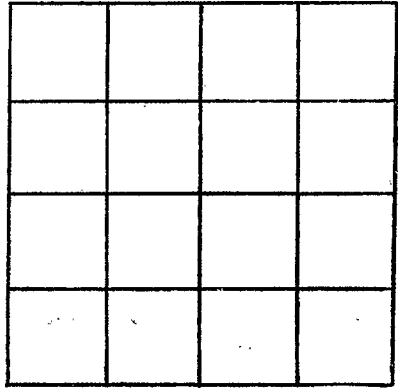

SECTION \_\_\_\_\_

Please indicate well location X.

ADDITIONAL INFORMATION

If more than one screen,  
show locations of each on sketch.