

UNION  
F 35  
9-25-72

**CODED** MISSISSIPPI  
BOARD OF WATER COMMISSIONERS  
416 North State Street  
Jackson, Mississippi 39201

**CODED**

WATER WELL DRILLERS LOG

**CODED**

Sept 25 1972 J. W. Wilkerson Union  
date well completed firm name county well located

LANDOWNER: Mike Neil Page  
Etta Miss  
(mailing address)

description of formations encountered	from	to
soil	0	1
Sand & Clay	1	49
Blue Rock	49	358
Water Rock	358	360
Water Sand & Root	360	460
Replay sand		

WELL LOCATION:  
sec 15 T 7 N R 1 E  
1 1/2 miles West of Enterprise  
(distance) (direction) (nearest town)

WELL PURPOSE:  
(home, irrigation, municipal, industrial)

- WELL COMPLETION DATA:
- (1) diameter (inches) 4"
  - (2) total depth (feet) 460 ft
  - (3) static water level (feet) 78 below top of ground
  - (4) casing steel, 63 ft (material) (depth)  
4" (size) if telescope see back.
  - (5) screen 0 (length), 0 (depth to top)  
0 (size), 0 (material)
  - (6) pump 1/2 HP sub 8 (HP) (yield gpm)  
Elec (type power)
  - (7) electric log NO (yes or no)  
(organization running log)
  - (8) how well bottom plugged

**CODED**


001 13 1072

DRILLERS REMARKS:

MISS. BD. C.  
WATER COMM

If well telescopes please sketch and show depths.

GROUND LEVEL

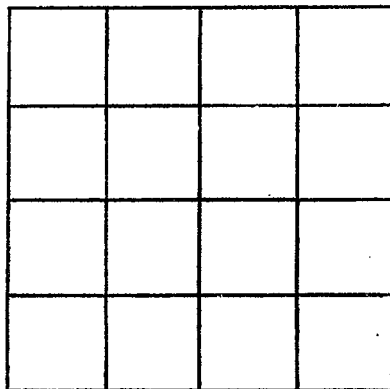

SECTION \_\_\_\_\_

Please indicate well location X.

ADDITIONAL INFORMATION

If more than one screen, show locations of each on sketch.