

Union
F36
3-11-72

MISSISSIPPI
BOARD OF WATER COMMISSIONERS
416 North State Street
Jackson, Mississippi 39201

CODED

WATER WELL DRILLERS LOG

3-11-72 19 *Junger Well Drilling* *Union*
date well completed firm name county well located

LANDOWNER:
Billy Farr
Rt #1, Myrtle Miss
(mailing address)

description of formations encountered	from	to
<i>mixed clay</i>	<i>0</i>	<i>350</i>
<i>sub-s. rock</i>	<i>350</i>	<i>500</i>

WELL LOCATION:
sec. 6 T. 7 N. R. 1 E. S. 5 W. of New Albany
(distance) miles (direction) of (nearest town)

WELL PURPOSE:
(home, irrigation, municipal, industrial)

- WELL COMPLETION DATA:
- (1) diameter (inches) 4"
 - (2) total depth (feet) 500
 - (3) static water level (feet) 50 below top of ground. above
 - (4) casing PVC 120
(material) (depth)
0 if telescope see back.
(size)
 - (5) screen 0 0
(length) (depth to top)
0 (size) 0 (material)
 - (6) pump 1 8
(HP) (yield gpm)
Electric
(type power)
 - (7) electric log no
(yes or no) 0
(organization running log)
 - (8) how well bottom plugged 0

CODED


APR 11 1972

MISSISSIPPI
STATE DEPT. OF
AGRICULTURE

DRILLERS REMARKS:

If well telescopes please sketch and show depths.

GROUND LEVEL

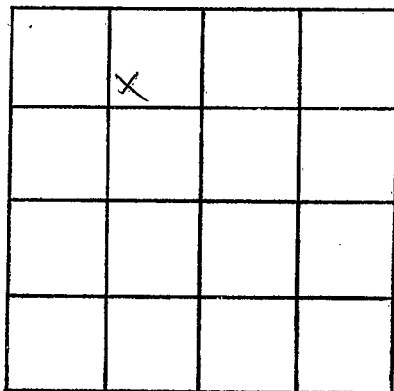

SECTION 6

Please indicate well location X.

ADDITIONAL INFORMATION

If more than one screen,
show locations of each on sketch.