

UNION
F 38
5-1-73

MISSISSIPPI
BOARD OF WATER COMMISSIONERS
416 North State Street
Jackson, Mississippi 39201

900 00
745 00
155 00
CODED

WATER WELL DRILLERS LOG

51
date well completed

19 73 Ft Medlin
firm name

UNION
county well located

LANDOWNER: Richard Hark

Richard Hark

description of formations encountered

from

to

Star R#

Clay

0

420

Harkover Flat

Rock & sand

420

420

(mailing address)

WELL LOCATION:

sec. 5 T. 7 N. R. 1 E.

3 miles W. Doreola
(distance) (direction) (nearest town)

WELL PURPOSE:

(home, irrigation, municipal, industrial)

WELL COMPLETION DATA:

- (1) diameter (inches) 4 1/2
- (2) total depth (feet) 420
- (3) static water level (feet) 43 below top of ground
- (4) casing (material) P (depth) 110
- (size) If telescope see back.
- (5) screen (length) (depth to top)
- (size) (material)
- (6) pump (HP) 3/4 (yield gpm) 6
- (type power)
- (7) electric log (yes or no)
- (organization running log)
- (8) how well bottom plugged

CODED


JUL 11 1973

DRILLERS REMARKS:

MISS. BD. OF

If well telescopes please sketch and show depths.

GROUND LEVEL

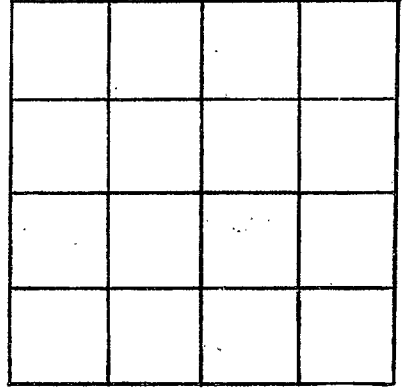

SECTION _____

Please indicate well location X.

ADDITIONAL INFORMATION

If more than one screen,
show locations of each on sketch.