

UNION
E 39
6-5-73

MISSISSIPPI
BOARD OF WATER COMMISSIONERS
416 North State Street
Jackson, Mississippi 39201

CODED
UNION
~~Tippan~~
county well located

WATER WELL DRILLERS LOG

6-5-73 19 Juniper Well Drilling firm name
date well completed

LANDOWNER:	description of formations encountered	from	to
Michael Cassitt Rt #2, Natche, Miss. (mailing address)			
WELL LOCATION: sec. <u>1</u> T <u>7</u> N R <u>3</u> E <u>4</u> miles <u>So</u> of <u>Dryville</u> (distance) (direction) (nearest town)	Clay	100	200
WELL PURPOSE: (home, irrigation, municipal, industrial)	Sand + gravel	200	350
WELL COMPLETION DATA: (1) diameter (inches) <u>4"</u>			
(2) total depth (feet) <u>350 ft</u>			
(3) static water level (feet) <u>140</u> below above top of ground.			
(4) casing <u>PVC</u> <u>150</u> (material) (depth) <u>4</u> if telescope see back. (size)			
(5) screen <u>0</u> <u>0</u> (length) (depth to top) <u>0</u> <u>0</u> (size) (material)			
(6) pump <u>1 1/2</u> <u>7</u> (HP) (yield gpm)			
(7) electric log <u>Elec</u> (type power)			
(7) electric log <u>No</u> (yes or no)			
(organization running log)			
(8) how well bottom plugged <u>0</u>			

CODED


JUN 7 1973

DRILLERS REMARKS:

MISSISSIPPI
BOARD OF WATER COMMISSIONERS

If well telescopes please sketch and show depths.

GROUND LEVEL

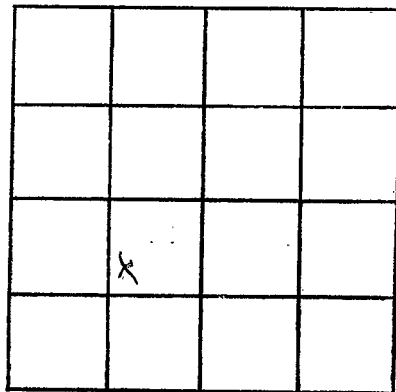

SECTION 1

Please indicate well location X.

ADDITIONAL INFORMATION

Lined area for additional information.

If more than one screen, show locations of each on sketch.