

**CODED**

900.00  
450.00  
450.00

UNION  
F40  
6-25-73

MISSISSIPPI  
BOARD OF WATER COMMISSIONERS  
416 North State Street  
Jackson, Mississippi 39201

**WATER WELL DRILLERS LOG**

6 25 1973 *J T Madlin* UNION  
date well completed firm name county well located

LANDOWNER:  
*Jenny Coffey*  
*Etta*  
(mailing address)

description of formations encountered	from	to
<i>red clay</i>	0	36
<i>blue "</i>	36	415
<i>rock hard</i>	40	320

WELL LOCATION:  
sec *27* T *7* N R *1*  
*4* miles *SE* of *Etta*  
(distance) (direction) (nearest town)

WELL PURPOSE:  
(home, irrigation, municipal, industrial)

**CODED**

WELL COMPLETION DATA:

(1) diameter (inches) 4

(2) total depth (feet) 320

(3) static water level (feet) 70 below above top of ground.

(4) casing P 100  
(material) (depth)  
         If telescope see back.  
(size)

(5) screen                    
(length) (depth to top)  
         (size) (material)

(6) pump 1 6  
(HP) (yield gpm)  
         (type power)

(7) electric log           
(yes or no)  
         (organization running log)

(8) how well bottom plugged         


DRILLERS REMARKS:

43

RD. 93  
FILED CODED

If well telescopes please  
sketch and show depths.

GROUND LEVEL

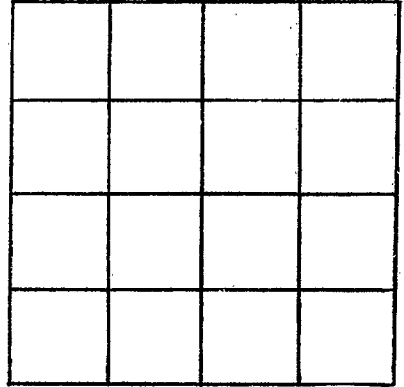

SECTION \_\_\_\_\_

Please indicate well location X.

ADDITIONAL INFORMATION

If more than one screen,  
show locations of each on sketch.