

CODED 800.00
40.00
840.00

UNION
F41
6-20-73

MISSISSIPPI
BOARD OF WATER COMMISSIONERS
416 North State Street
Jackson, Mississippi 39201

WATER WELL DRILLERS LOG

6 20 1973 *J F Needles* UNION
date well completed firm name county well located

LANDOWNER:
Joe. Hahn
R. ~~Smith~~ E. Hahn
(mailing address)

description of formations encountered	from	to
<i>red clay</i>	0	12
<i>blueish clay</i>	12	260
<i>black sand</i>	360	400

WELL LOCATION:
sec *17* T *2* N R *1* E
2 miles NW of *Enterprise*
(distance) (direction) (nearest town)

WELL PURPOSE:
(home, irrigation, municipal, industrial)

- WELL COMPLETION DATA:
- (1) diameter (inches) 7
 - (2) total depth (feet) 400
 - (3) static water level (feet) 60 below above top of ground.
 - (4) casing P 75
(material) (depth)
 if telescope see back.
(size)
 - (5) screen (length) (depth to top)
(size) (material)
 - (6) pump 3/4 3
(HP) (yield gpm)
E
(type power)
 - (7) electric log
(yes or no)

(organization running log)
 - (8) how well bottom plugged


CODED

JUL 23 1973

DRILLERS REMARKS:

If well telescopes please
sketch and show depths.

GROUND LEVEL

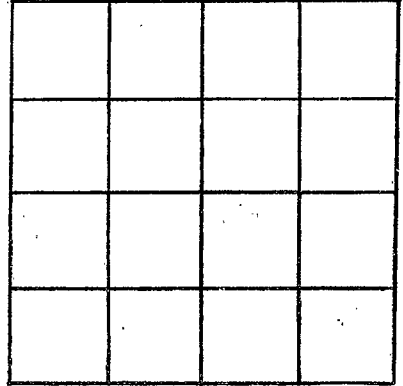

SECTION _____

Please indicate well location X.

ADDITIONAL INFORMATION

If more than one screen,
show locations of each on sketch.