

UNION
F43
8-3-73

MISSISSIPPI
BOARD OF WATER COMMISSIONERS
416 North State Street
Jackson, Mississippi 39201

CODED

WATER WELL DRILLERS LOG

8-3-1973 date well completed
Leeper Drilling Co firm name
Union county well located

LANDOWNER:
Joy Williams
Rt 1 Etta, Miss
(mailing address)

description of formations encountered	from	to
Red Clay + Sand	0	40
Red sand + Rock	40	65
Rock + Blue Clay	65	105
Blue Clay	105	200
Blue Clay + Rock	200	350
Chalk + Rock	350	500
Rock + streaks of sand	500	560
Sand	560	675

WELL LOCATION:
sec. 16 T 7 R 1 E
6 miles S of Etta
(distance) (direction) (nearest town)

WELL PURPOSE: Home
(home, irrigation, municipal, industrial)

- WELL COMPLETION DATA:**
- (1) diameter (inches) 4
 - (2) total depth (feet) 675
 - (3) static water level (feet) 120 below top of ground.
 - (4) casing steel 148 (material) (depth)
 - (size) If telescope see back.
 - (5) screen none (length) (depth to top)
 - (size) (material)
 - (6) pump 3/4 10 (HP) (yield gpm)
 - Elect- (type power)
 - (7) electric log no- (yes or no)
 - (organization running log)
 - (8) how well bottom plugged open


CODED

DRILLERS REMARKS:

1973

If well telescopes please sketch and show depths.

GROUND LEVEL

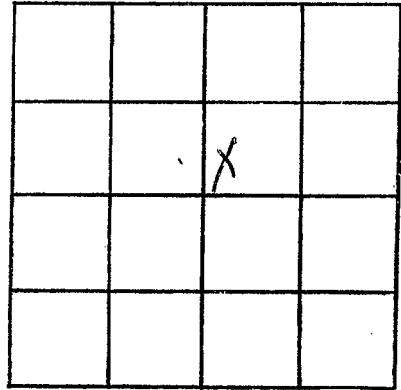

SECTION 16

Please indicate well location X.

ADDITIONAL INFORMATION

Lined area for additional information.

If more than one screen, show locations of each on sketch.