

UNION
 FAA
 6-18-73

MISSISSIPPI
 BOARD OF WATER COMMISSIONERS
 416 North State Street
 Jackson, Mississippi 39201

CODED

WATER WELL DRILLERS LOG

6-18-1973 date well completed
 Leeper Drilling Co firm name
 Lenoir county well located

LANDOWNER:
 Redus W. Wiseman
 Rt-1 Etta, Miss
 (mailing address)

description of formations encountered	from	to
White Clay + sand	0	25
Sand - Red-	25	45
Blue Clay	45	120
Blue Clay + Rock	120	200
Rock + sand	200	300

WELL LOCATION:
 sec. 10 T. 7 N. R. 5 E
 8 miles N.W. of Cow
 (distance) (direction) (nearest town)

WELL PURPOSE: Home
 (home, irrigation, municipal, industrial)

WELL COMPLETION DATA:

(1) diameter (inches) 4

(2) total depth (feet) 300

(3) static water level (feet) 30 below top of ground.

(4) casing 4" (material) 84 (depth)
 4 (size) if telescope see back.

(5) screen open (length) (depth to top)
 (size) (material)

(6) pump 3/4 (HP) 10 (yield gpm)
 Elect (type power)

(7) electric log no (yes or no)
 (organization running log)

(8) how well bottom plugged open


CODED

DRILLERS REMARKS:

MISS. 8 1973

If well telescopes please sketch and show depths.

GROUND LEVEL

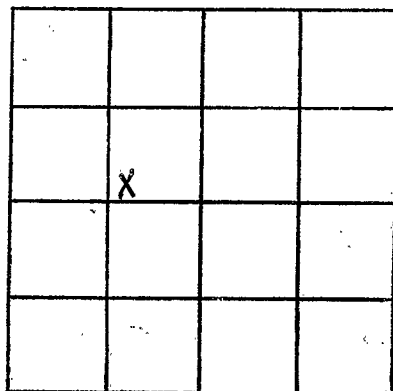

SECTION 10

Please indicate well location X.

ADDITIONAL INFORMATION

If more than one screen,
show locations of each on sketch.