

UNION
F 45
7-19-74

MISSISSIPPI
BOARD OF WATER COMMISSIONERS
416 North State Street
Jackson, Mississippi 39201

CODED

WATER WELL DRILLERS LOG

July 19 1974 J. W. Webb & Sons Union
date well completed firm name county well located

LANDOWNER: C. T. Murphy

description of formations encountered

from to

New Albany
(mailing address)

Soil	0	1
pipe clay	1	51
Blue Rock	51	163
Water Rock & Sand	163	280
Ripley sand		

WELL LOCATION:

sec. 20 T. 75 N R. 1 E
1 miles South of Poolville
(distance) (direction) (nearest town)

WELL PURPOSE:
(home, irrigation, municipal, industrial)

WELL COMPLETION DATA:

- (1) diameter (inches) 4
- (2) total depth (feet) 280
- (3) static water level (feet) 80 below top of ground.
- (4) casing Steel 63 ft (material) (depth)
4" (size) if telescope see back.
- (5) screen 0 (length) (depth to top)
(size) (material)
- (6) pump Inset 4 (HP) (yield gpm)
Elec (type power)
- (7) electric log (yes or no)
(organization running log)
- (8) how well bottom plugged

CODED


RECEIVED
AUG - 8 1974

DRILLERS REMARKS:

MISS. BD. OF WATER COMMISSIONERS

If well telescopes please sketch and show depths.

GROUND LEVEL

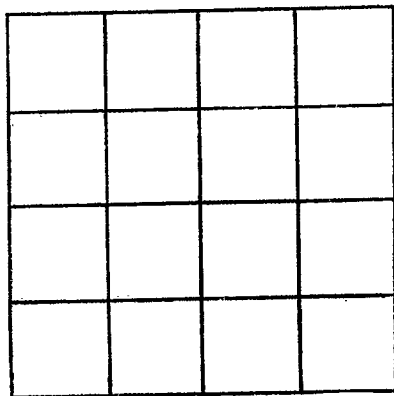

SECTION _____

Please indicate well location X.

ADDITIONAL INFORMATION

If more than one screen, show locations of each on sketch.